




T. 28&29S. R. 4W. W.M.

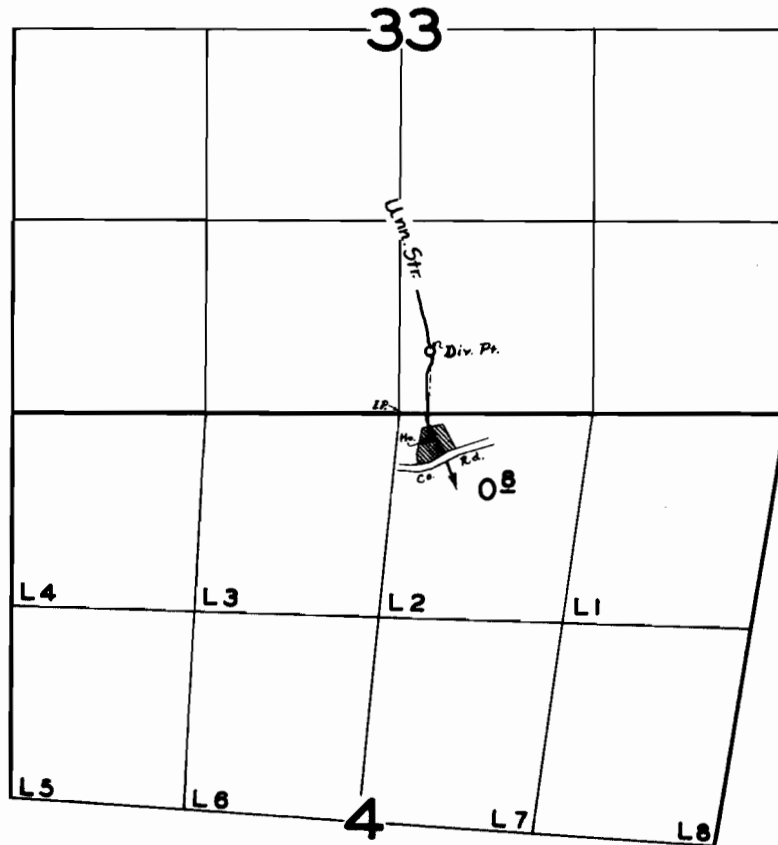

**FINAL PROOF SURVEY**  
UNDER

Application No. 30627 Permit No. 24213  
IN NAME OF

DOROTHY E. & CARL E. JAMES

Surveyed JUN. 23 1959, by M. BISH