


# T. 9S. R. 26&27E. W.M.

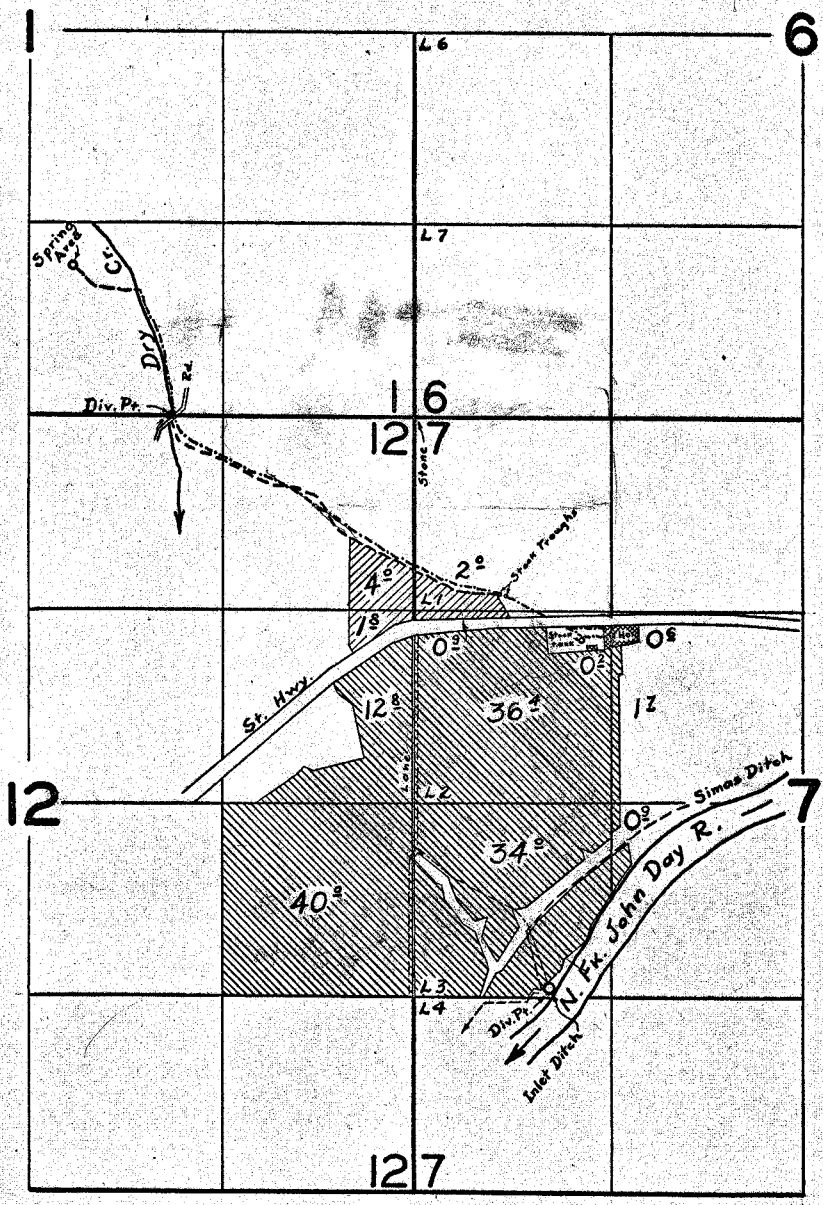

## FINAL PROOF SURVEY

UNDER

Application No. 21686 Permit No. 17030

IN NAME OF

CLARENCE E. HOLMES

Surveyed AUG. 13 1959, by M. BISH