



P-24837
27642

T. 13S. R. 30E. W.M.

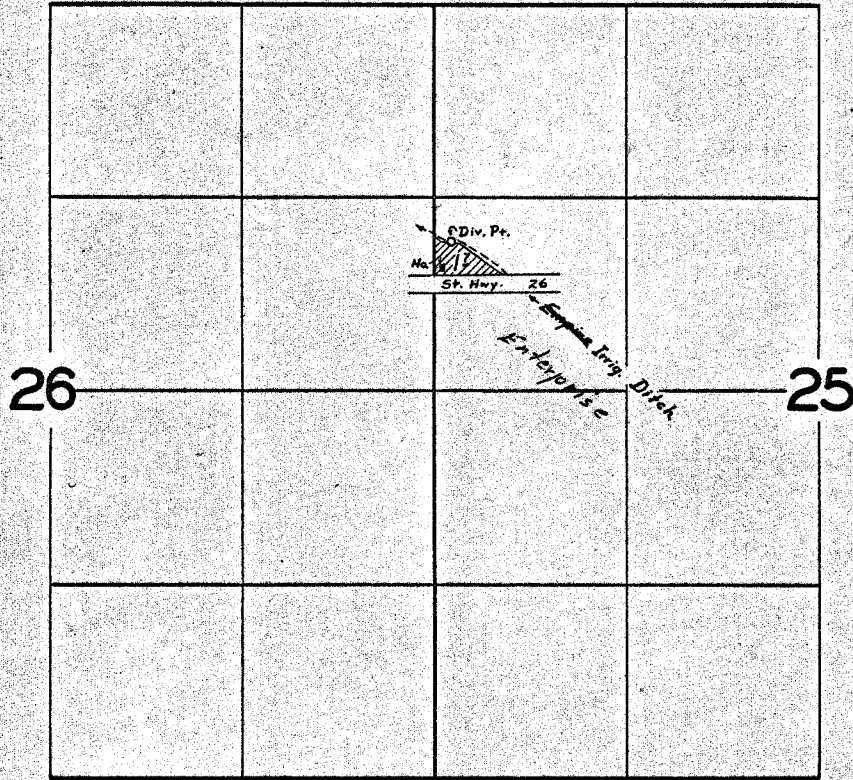

T. 13S. R. 31E.
Sec. 20
NW¼ SW¼

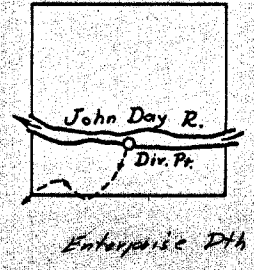

FINAL PROOF SURVEY

UNDER

Application No. 31414 Permit No. 24837

IN NAME OF

Katherine J. Eismann

Surveyed Aug. 10 19 59, by M. Bish