


Per 26098  
27643

T. 13S. R. 32E. W.M.

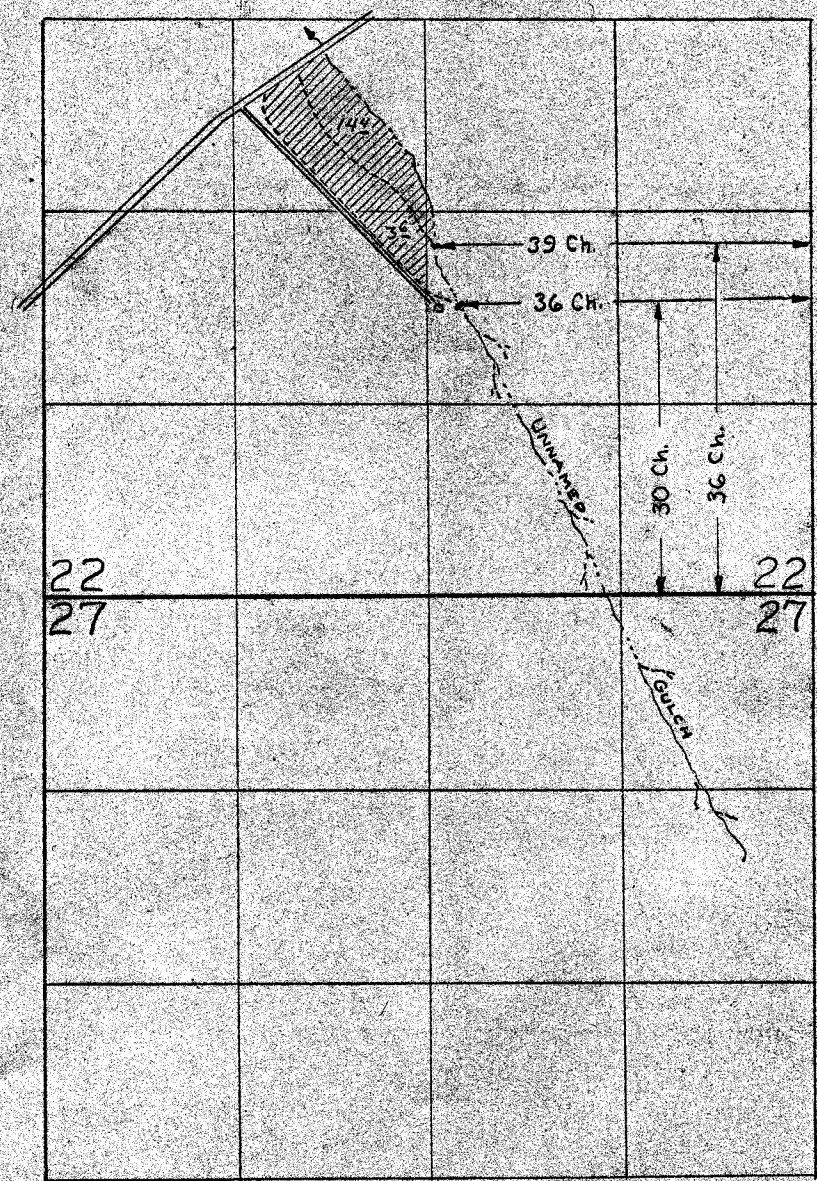

RECEIVED  
MAR 31 1959  
STATE ENGINEER  
SALEM, OREGON

Application No. 33008  
Permit No. 26098