


T.18&19 S. R.33½ E.W.M.

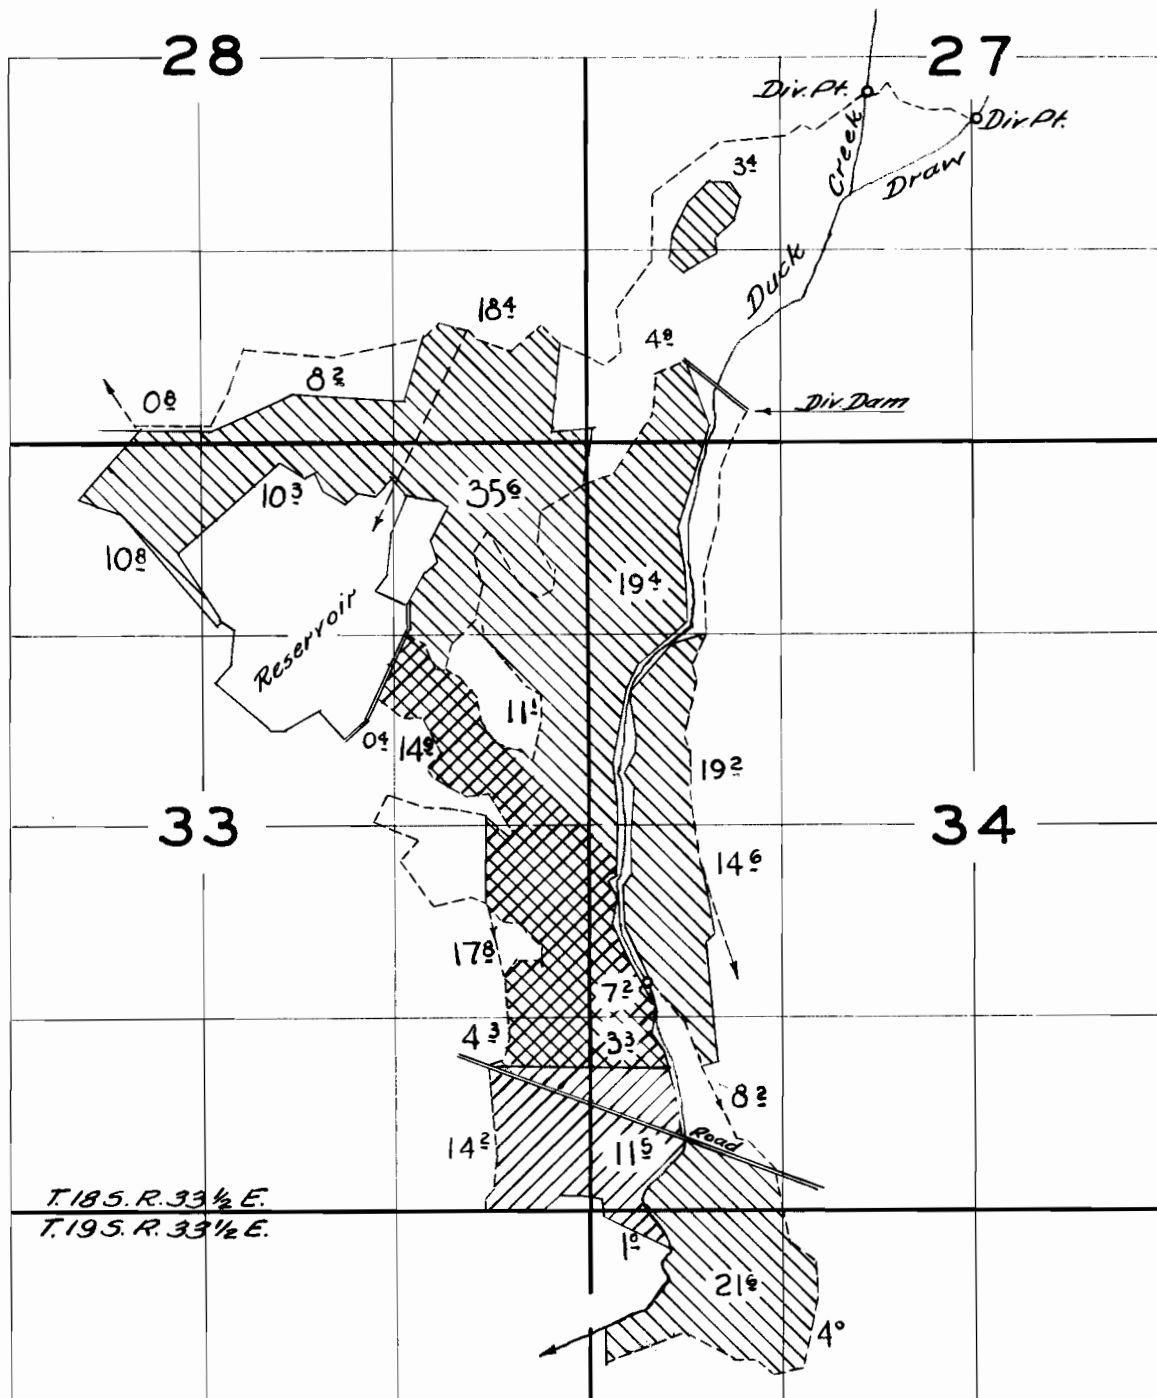

Appl. 26219

FINAL PROOF SURVEY
UNDER

Appl. 24389

Application No. ²⁴³⁸⁹ R-26218 ¹⁹¹⁵⁵ Permit No. ¹⁹¹⁵⁵ R-1178 20467
IN NAME OF

Hugh W. Jones

Surveyed *Aug 14* 1958, by *W. N. Perry*