


T.36S. R.6W.W.M.

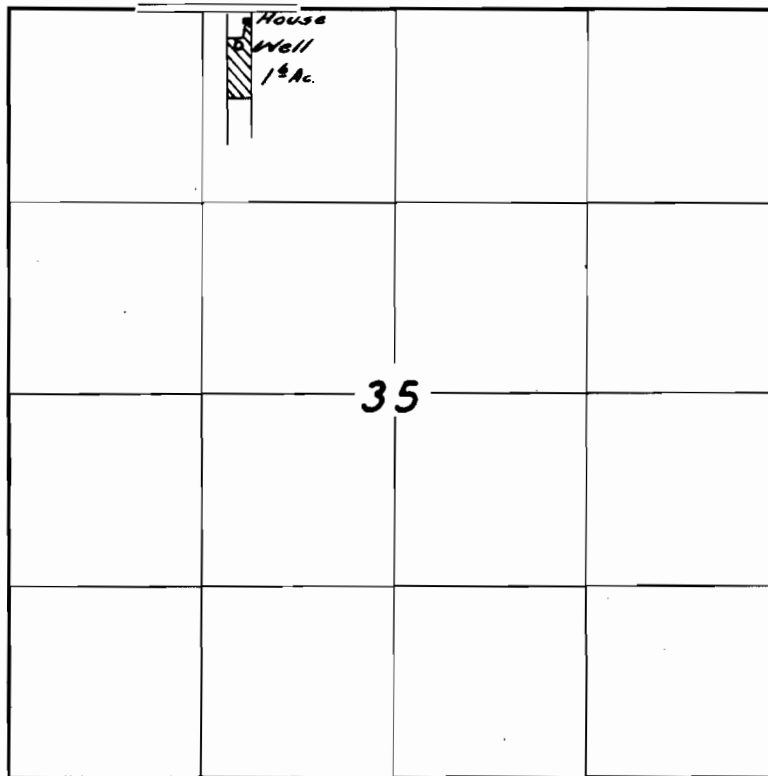

FINAL PROOF SURVEY

UNDER

Application No. G-772 Permit No. G-702

IN NAME OF

Arthur & Addie M. Richardson

Surveyed July 15, 1952, by C. O. Bartels