


T37S. R.5W.11M

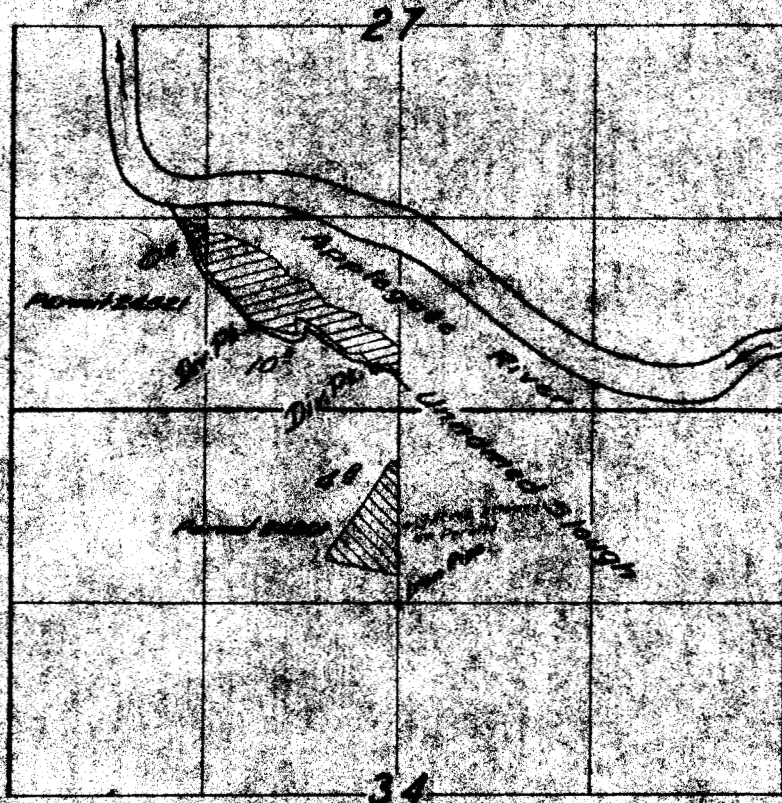

FINAL PLAN OF SURVEY

FOR

Application No. 3451 Permit No. 2400

IN NAME OF

Doc H. Jackson

Surveyed July 21, 1900 by W. H. Smith