


T. 37 S., R. 5 W., W. M.
Scale 4" = 1 mile Sept. 1956
Don H. Jackson

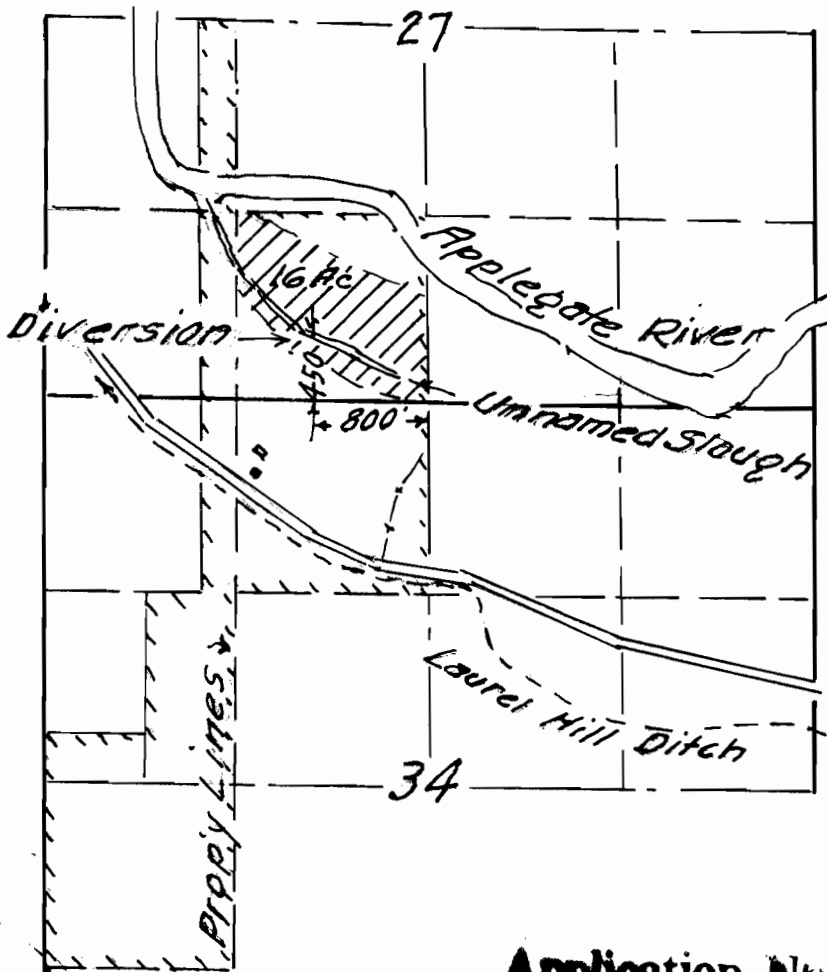

Application No 31131
Permit No. 24521