


T. 37 S. R. 5 W. W. M.

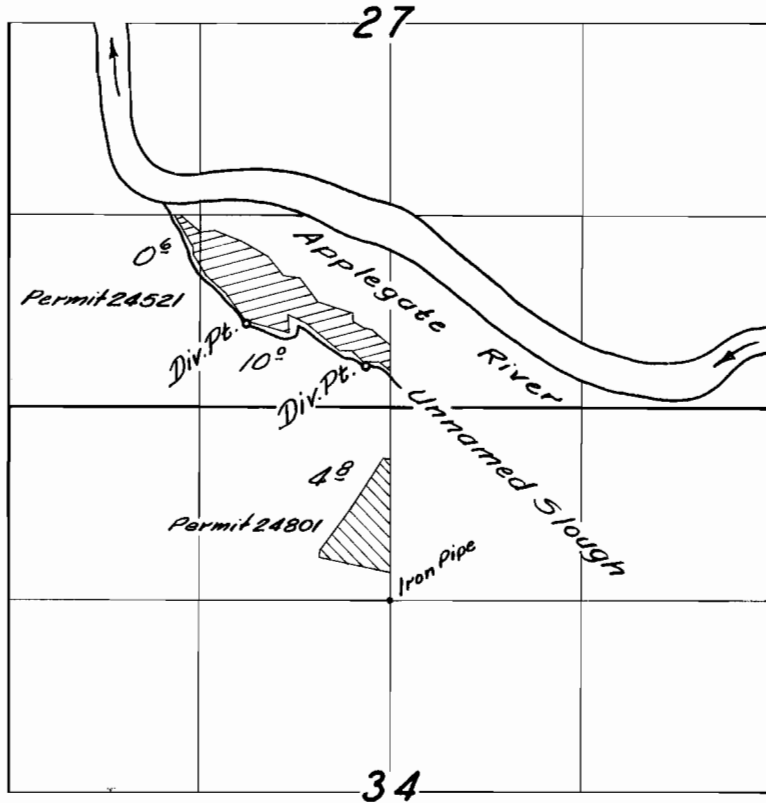

FINAL PROOF SURVEY

UNDER

Am. Rec. No. 31131 Permit No. 24521
31451 Permit No. 24801

IN FAVOR OF

Don H. Jackson

Surveyed July 21, 1959, by C. B. Bartels