


T. 34S. R. 6E. W.M.

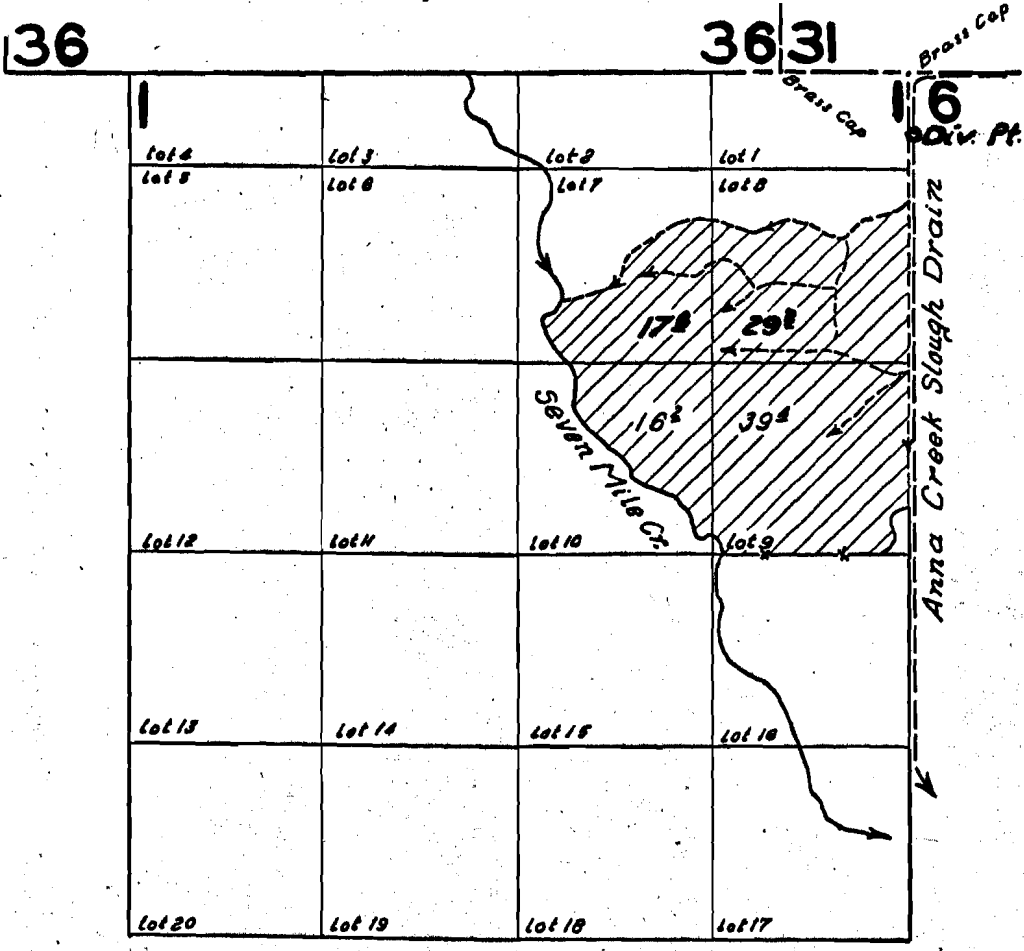

Seven mile Cr. mac.

FINAL PROOF SURVEY UNDER

Application No. 27098 Permit No. 24666

IN NAME OF

Robert D. & Marjorie Neill Helms

Surveyed Oct. 22 19 59., by R.H. Jackson

SR