


T. 36 S. R. 12 E. W.M.

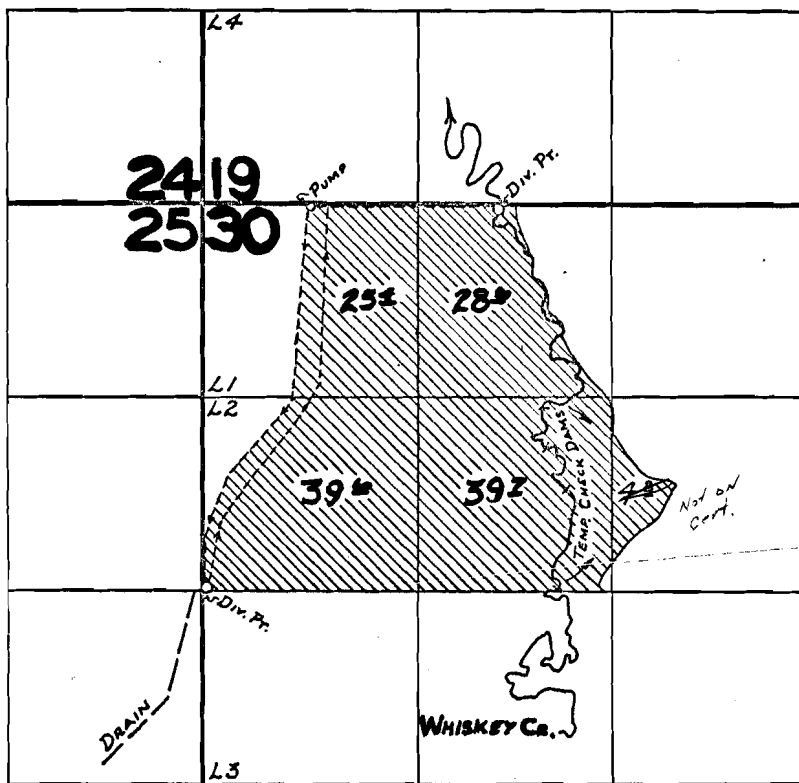

Whiskey Co. & Misc.

FINAL PROOF SURVEY UNDER

Application No. 28752 Permit No. 25221
IN NAME OF

WILFRED J. & MARY E. FIRSICK

Surveyed Oct. 14 1959, by R. H. JACKSON