


4 prints.

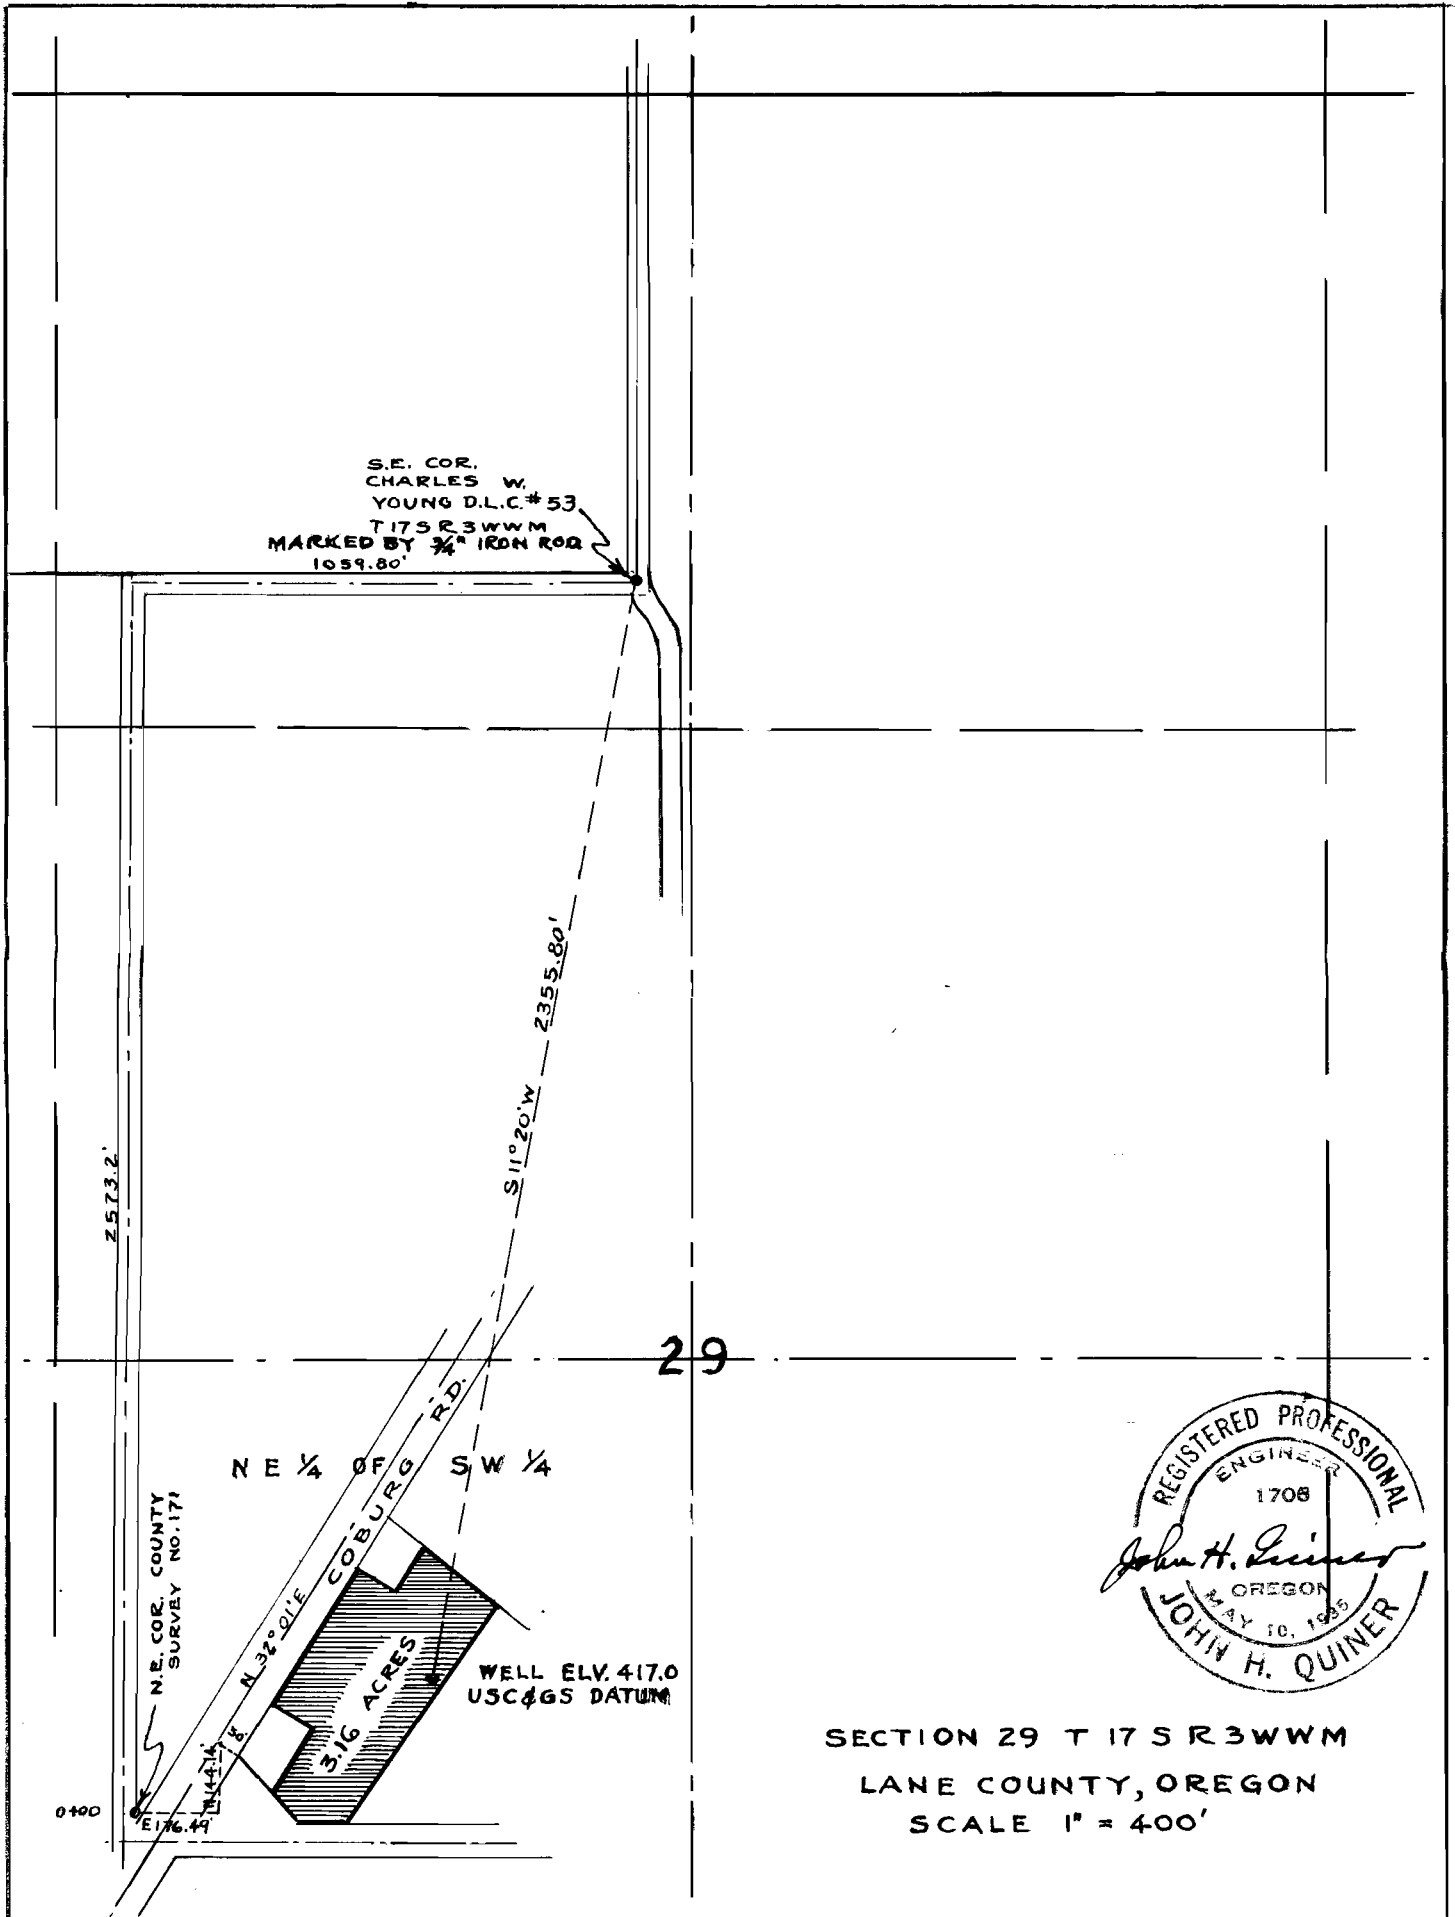

Application No. G-458

Permit No. G-321