


T. 17S. R. 5W. W.M.

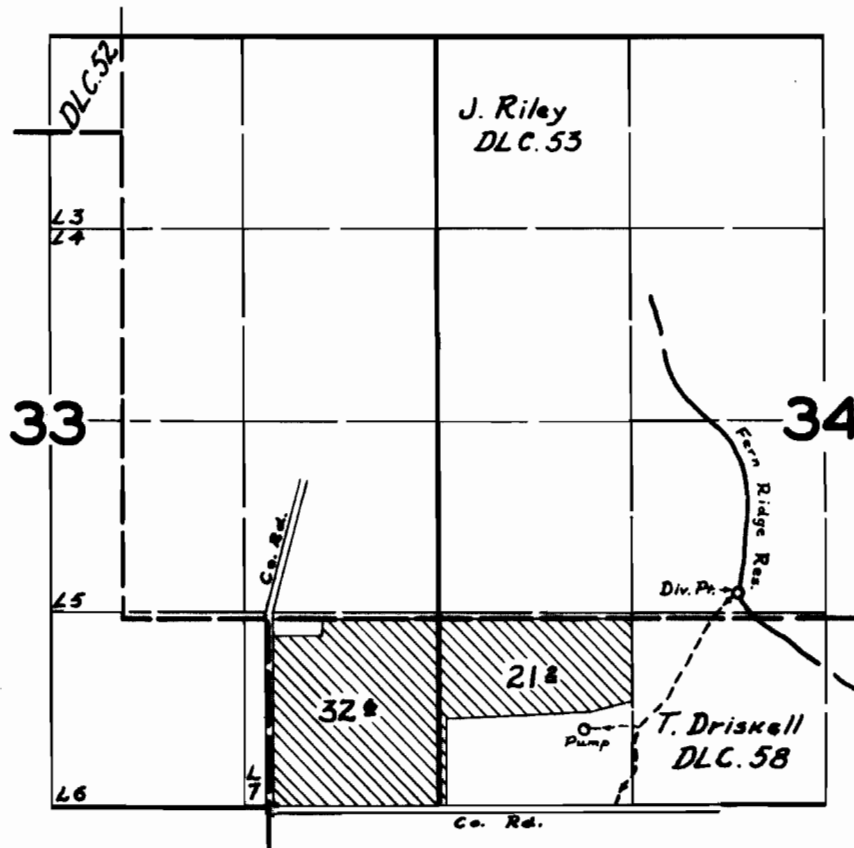

FINAL PROOF SURVEY

UNDER

Application No. 29432 Permit No. 23038

IN NAME OF

Chester R. Cook

Surveyed Apr. 3 1959, by C.O. Bartels