


T.
17
S.

T.
18.

S.

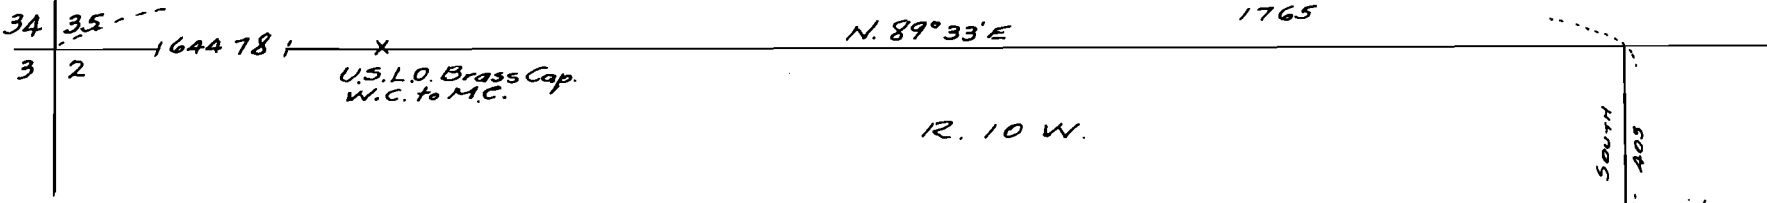


R. 10 W.

LOT 3

I, WM. J. BRAYTON, OF FLORENCE OREGON,
 CERTIFY THIS MAP WAS MADE FROM NOTES
 TAKEN BY ME DURING AN ACTUAL SURVEY ON
 JULY 29TH, 1957.

Wm J. Brayton

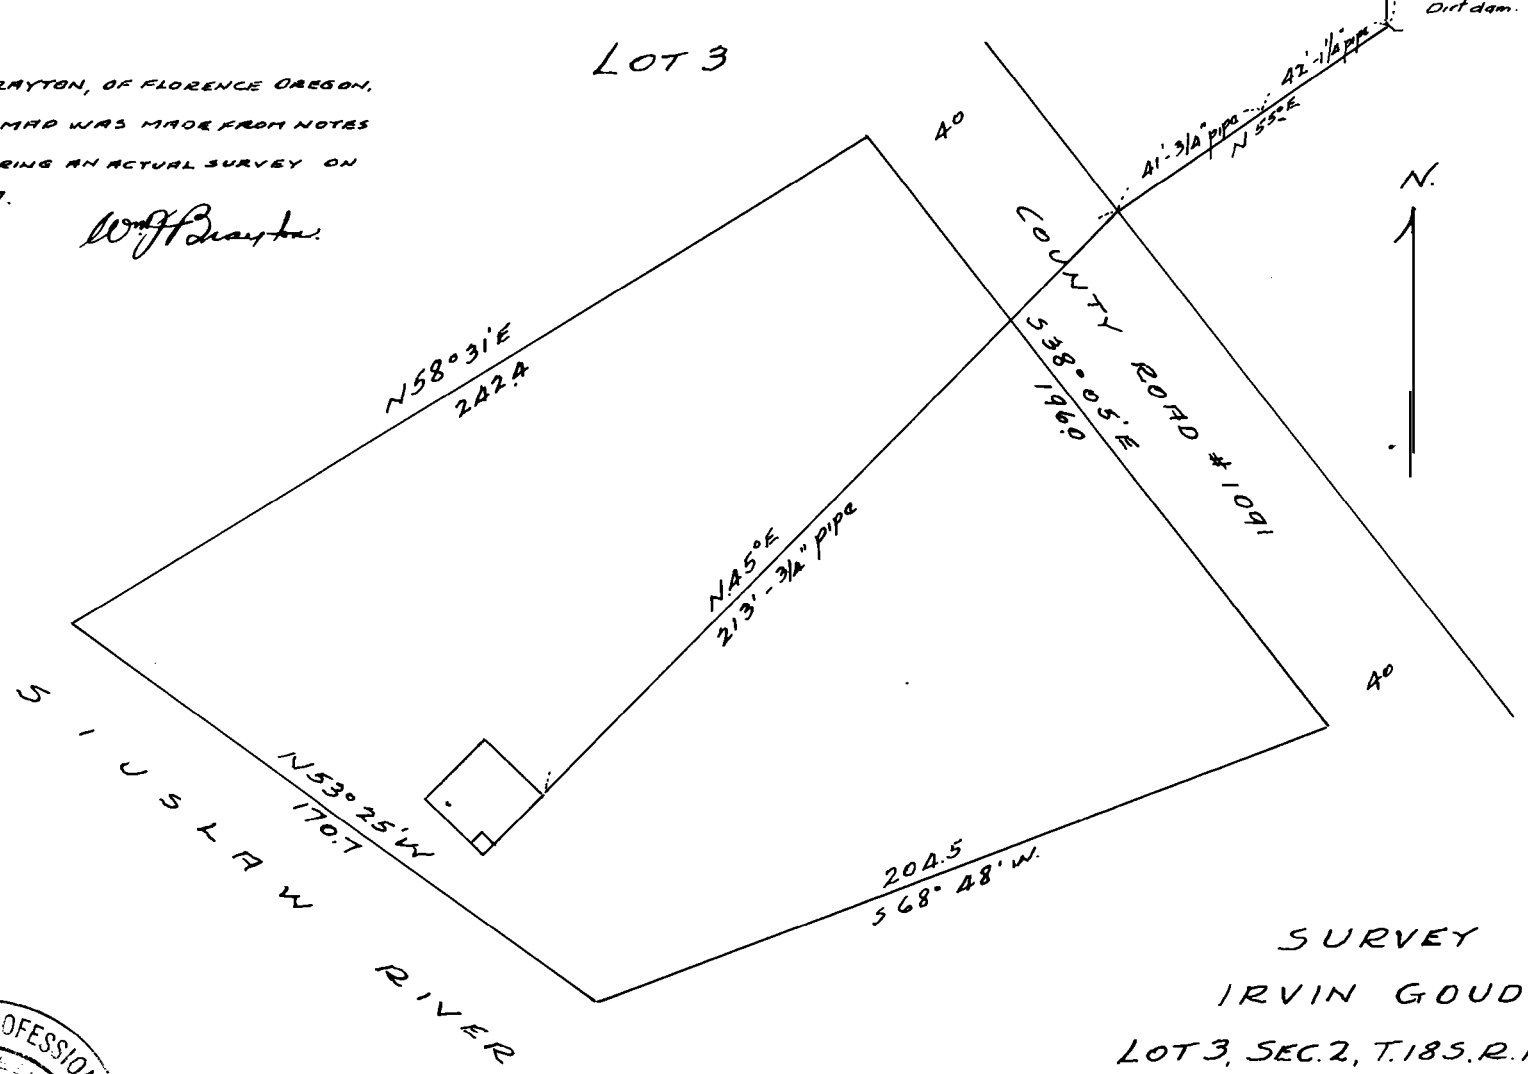

SURVEY
 IRVIN GOUDE
 LOT 3, SEC. 2, T. 18 S. R. 10 W. W. M.
 LANE COUNTY
 Scale 1" = 50' July '57.



Application No. 31960
 Permit No. 25212