


T2N R11E WM

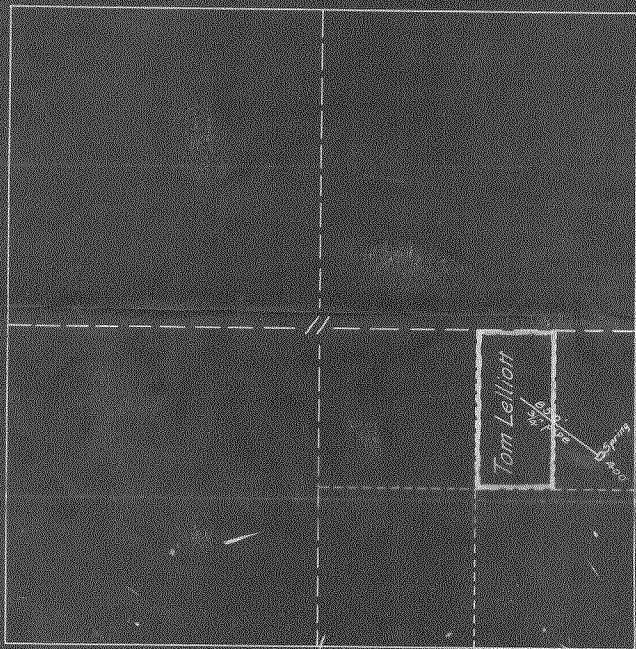

Scale 1 in = 800 ft.

3102