


T. 14 & 15 S. R. 11 W. W.M.

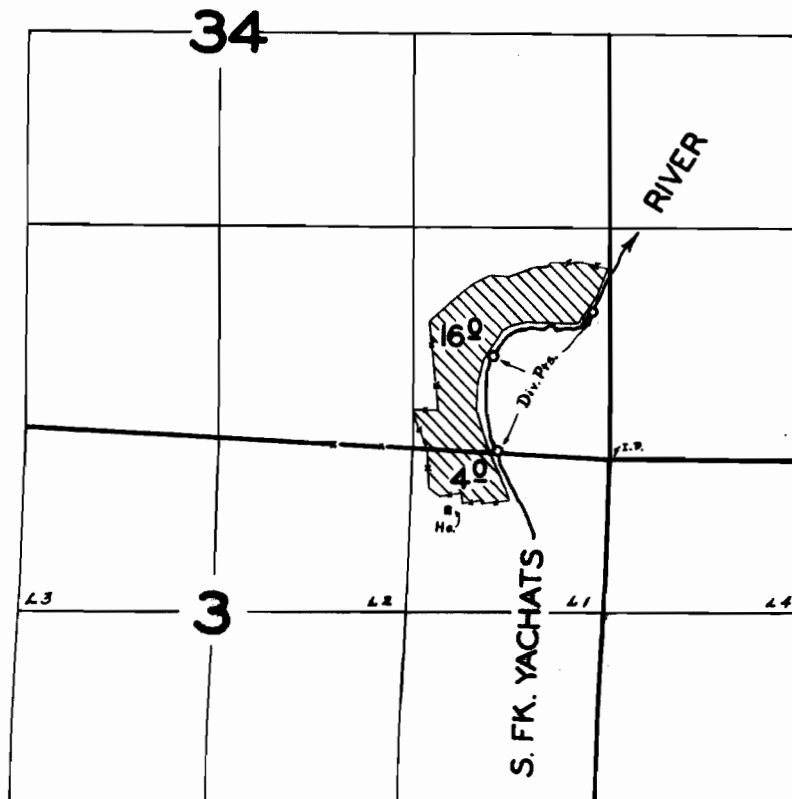

FINAL PROOF SURVEY
UNDER

Application No. 29675 Permit No. 23369
IN NAME OF

JACK BLAIN

Surveyed APR. 7 1959, by M. BISH