


T. 13S. R. 11W. W.M.

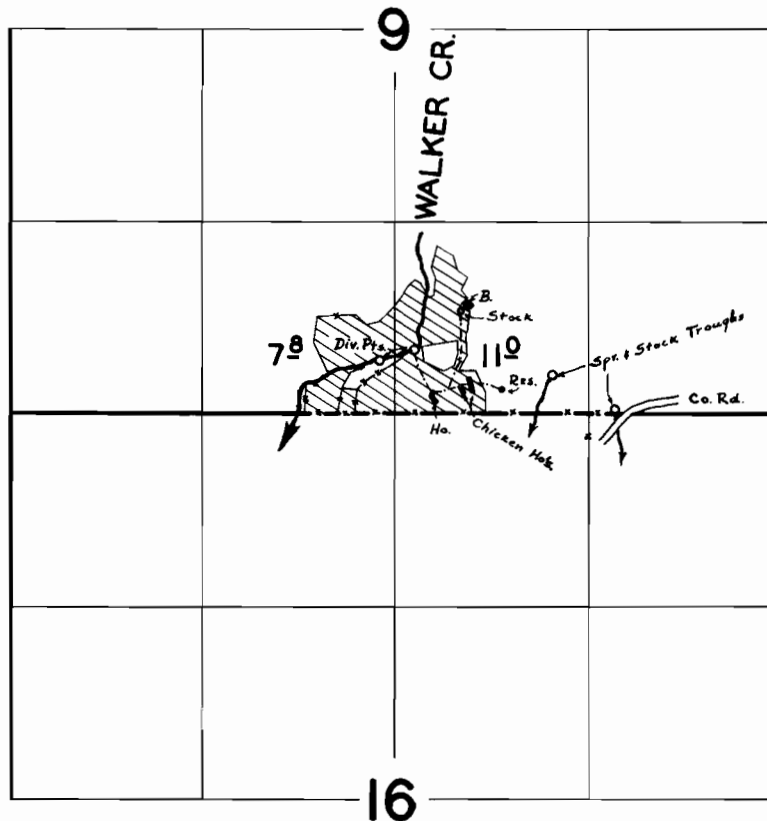

FINAL PROOF SURVEY
UNDER

Application No. 29848 Permit No. 23471
IN NAME OF

J. W. BENEFIEL

Surveyed APR. 8 1959, by M. BISH