


T. 11-12 S. R. 11 W. W. M.

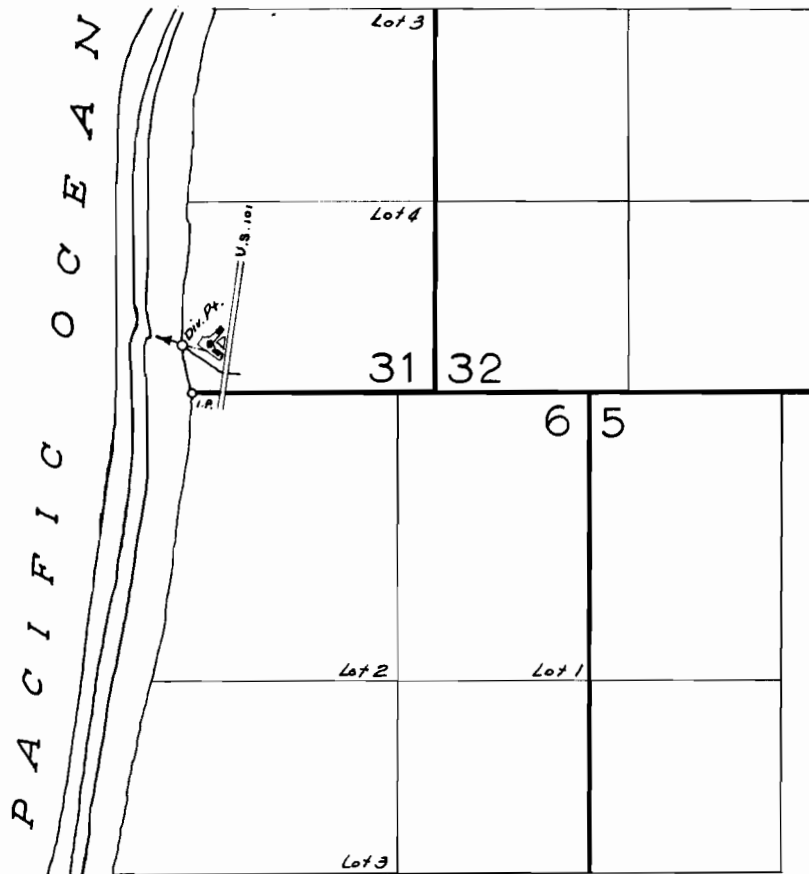

FINAL PROOF SURVEY
UNDER

Application No. 31724 Permit No. 25033
IN NAME OF

EARL W. & WALDEAN NEWSOM

Surveyed 30 April 1959, by RH Jackson