


T. 14S. R. 1W. W.M.

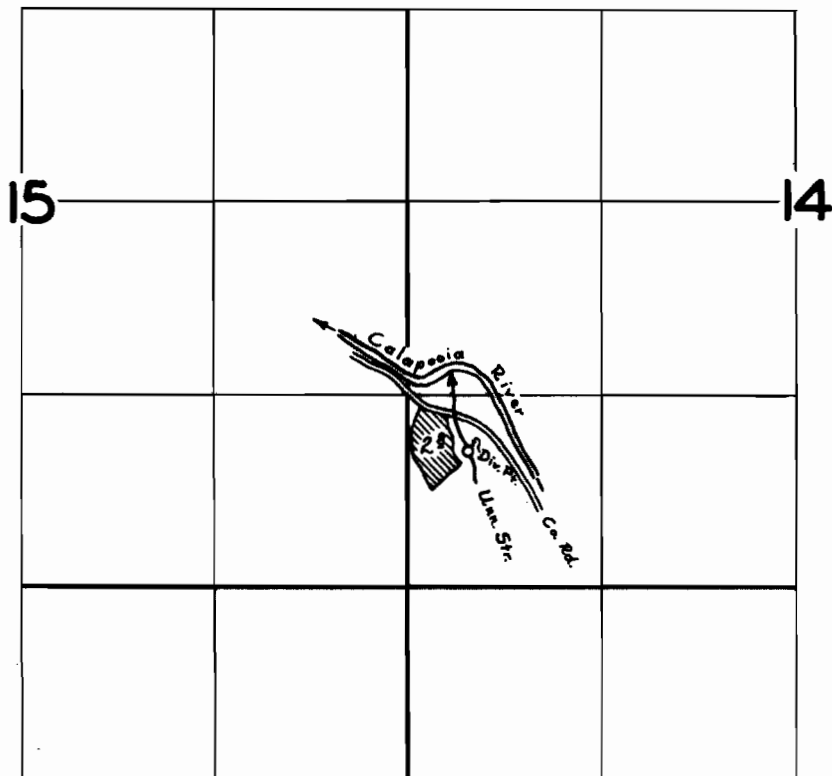

FINAL PROOF SURVEY

UNDER

Application No. 29349 Permit No. 23128

IN NAME OF

Stanley Duane & Donna Carol Ego

Surveyed Sept. 4, 1959, by C. O. Bartels