


T. 12S. R. 2W. W.M.

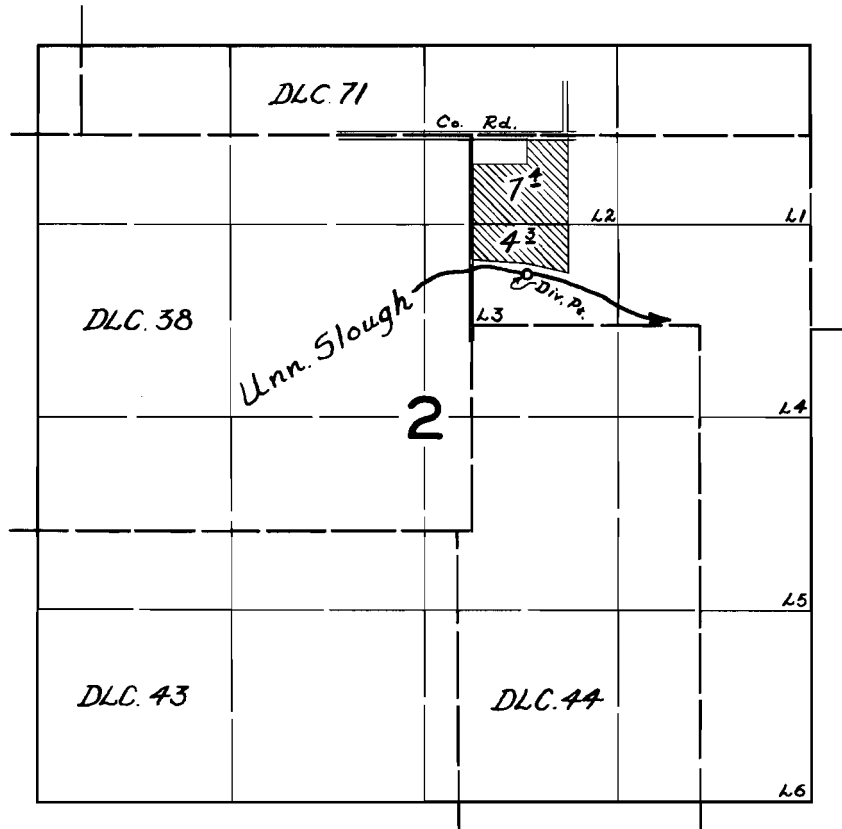

FINAL PROOF SURVEY

UNDER

Application No 29892 Permit No. 23539

IN NAME OF

Mrs. Lena Dillard

Surveyed Aug 28 1959, by C. O. Bartels