


T. 13S. R. 1E. W.M.

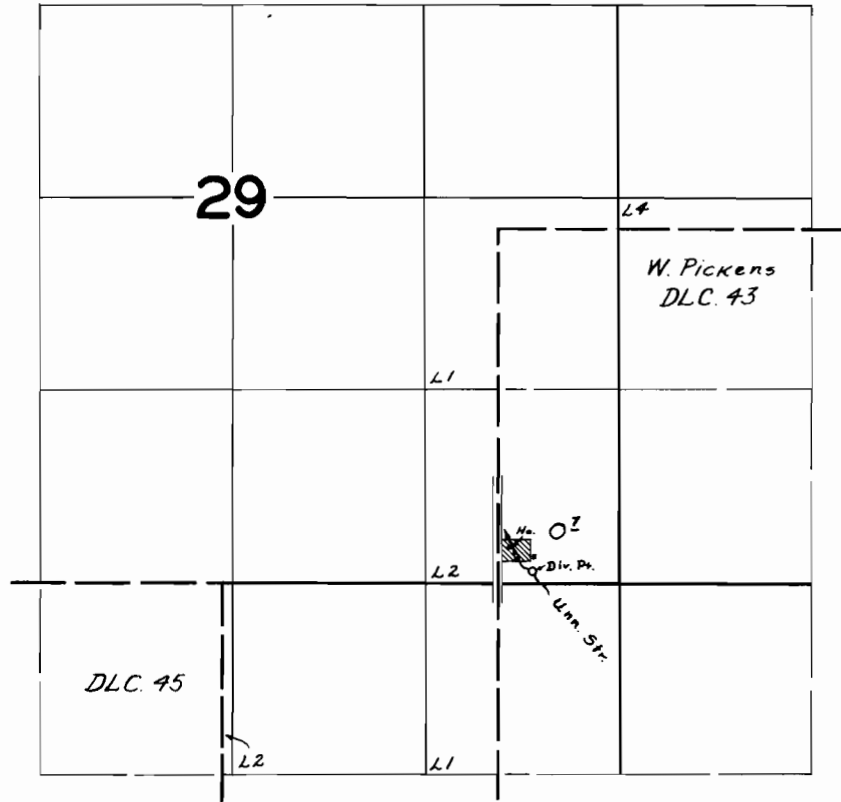

FEDERAL ROOF SURVEY

UNDER

Map No. 32679 and 25831

NAME OF

Lynn B. Yaden

Surveyed Sept. 1, 1959, by C.O. Bartels