


T. 6S. R. 2W. WM.

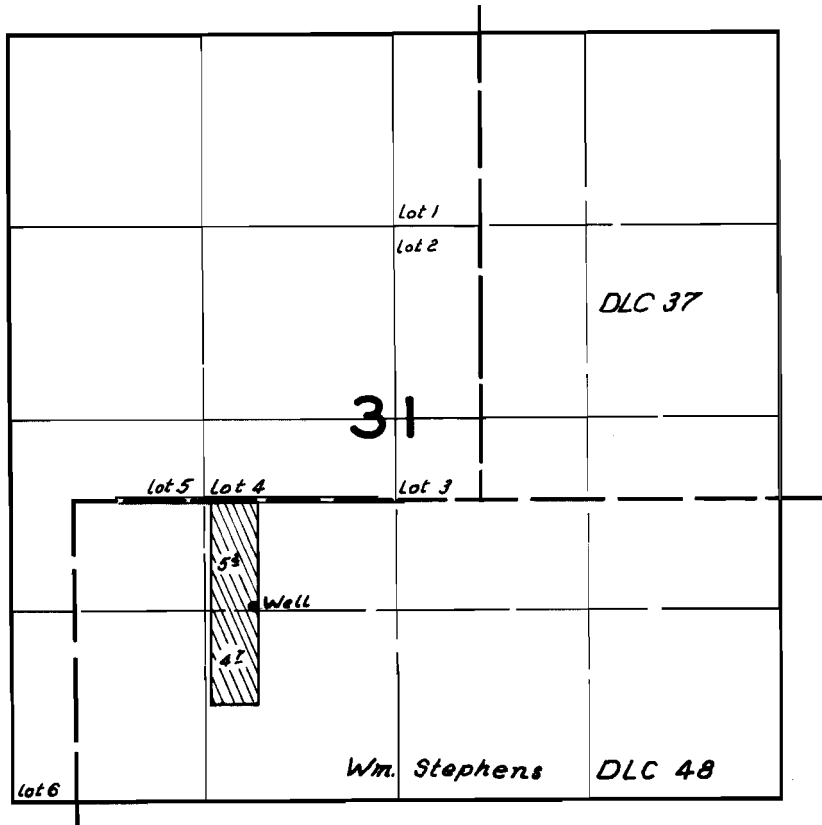

FINAL PROOF SURVEY
UNDER

Application No. *G232* Permit No. *0143*
IN NAME OF

Roy Farley

Surveyed *June 11, 1959*, by *C. O. Bartels*