


T. 6S. R. 2W.W.M.

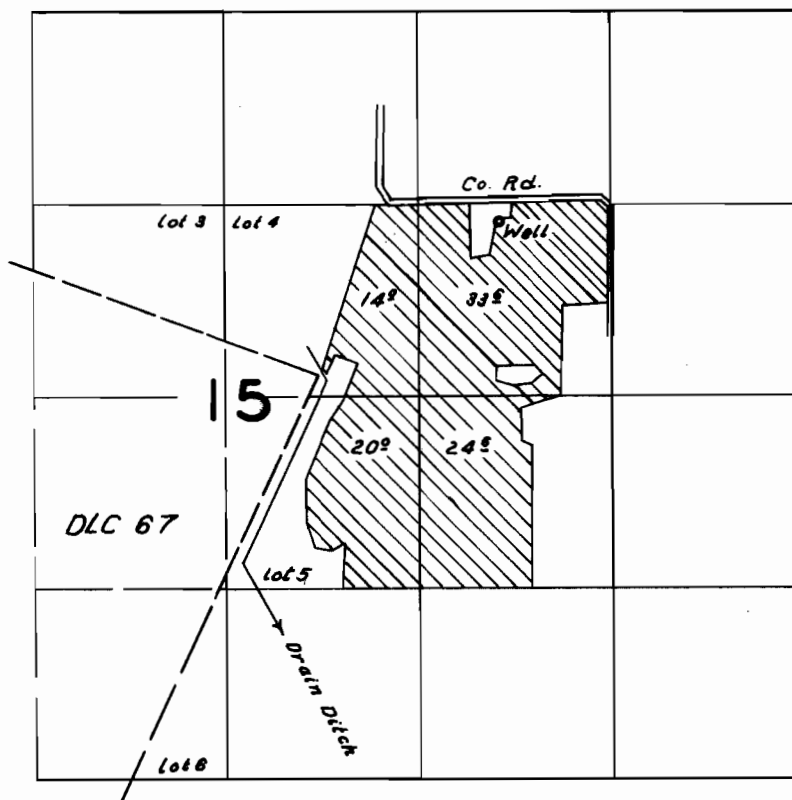

FINAL PROOF SURVEY UNDER

Application No. *G253* Permit No. *G153*
IN NAME OF

Mrs. Areta V. Harper

Surveyed *May 29 1959*, by *C.O. Bartels*