


T. 6S. R. 1W. W.M.

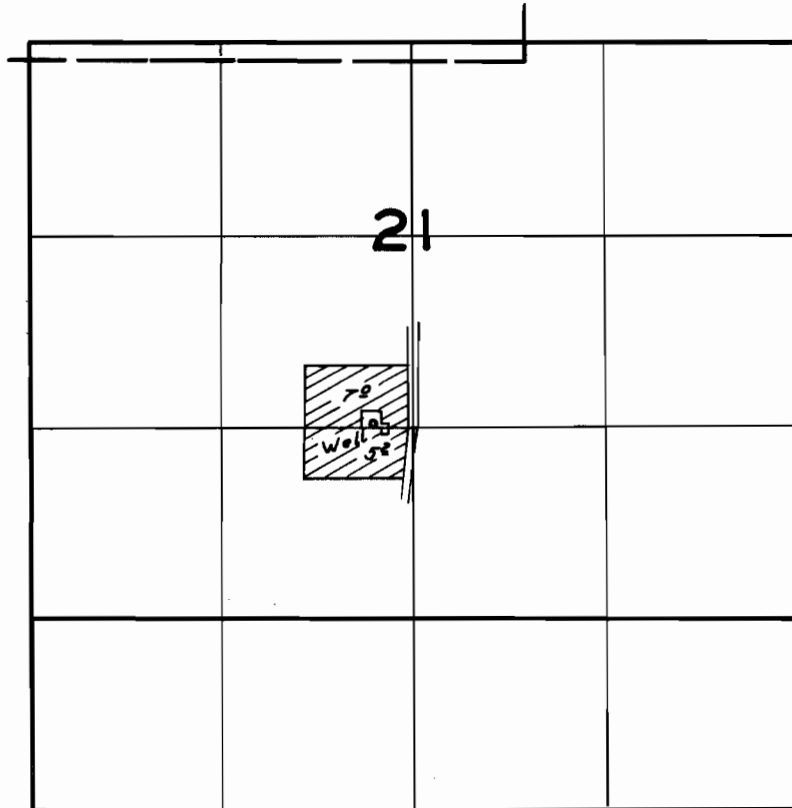

FINAL PROOF SURVEY
UNDER

Application No. *G272* Permit No. *G175*
IN NAME OF

Alfred A. Fisher

Surveyed *May 27 1959*, by *C.O. Bartels*