


T. 5S. R. 1W. W.M.

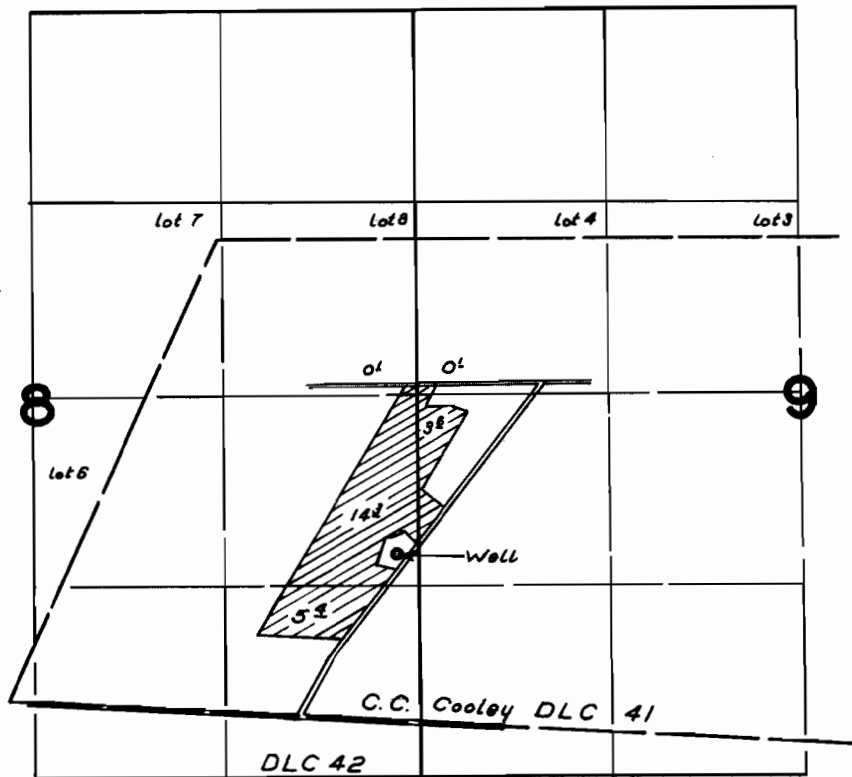

FINAL PROOF SURVEY UNDER

Application No. *G359* Permit No. *G244*
IN NAME OF

Fred L. Allen

Surveyed *April 23 1959* by *R.H. Jackson*