


T. 9S. R. 3W. W.M.

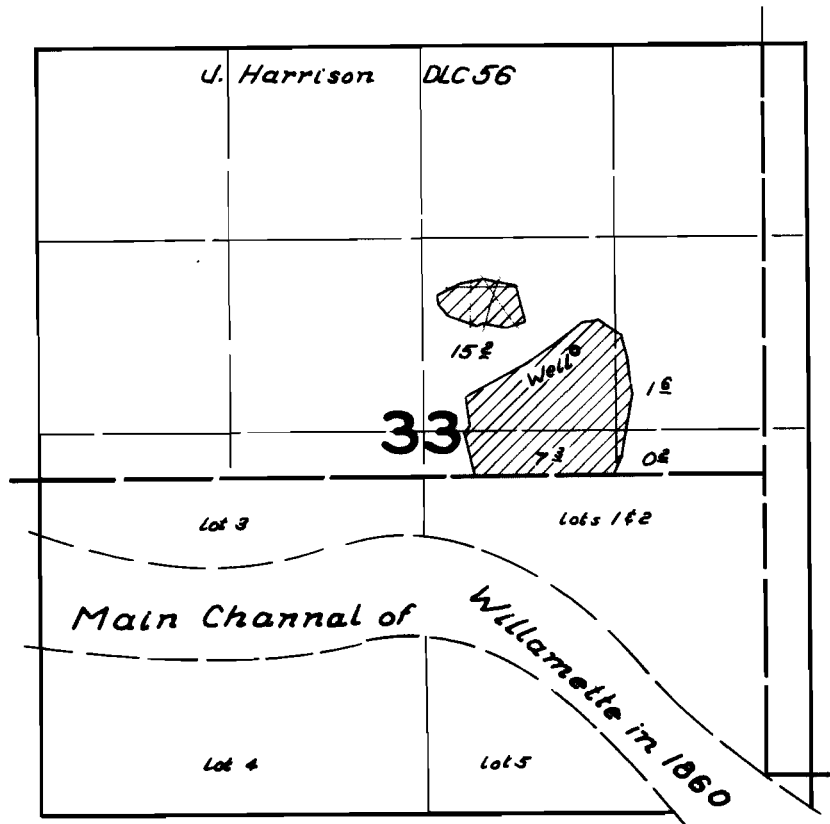

FINAL PROOF SURVEY
UNDER

Application No. *G890* Permit No. *G778*
IN NAME OF

Elmer L. Cook

Surveyed *May 1* 1959, by *C. O. Bartels*