


T. 9 S., R. 1 W. W.M.

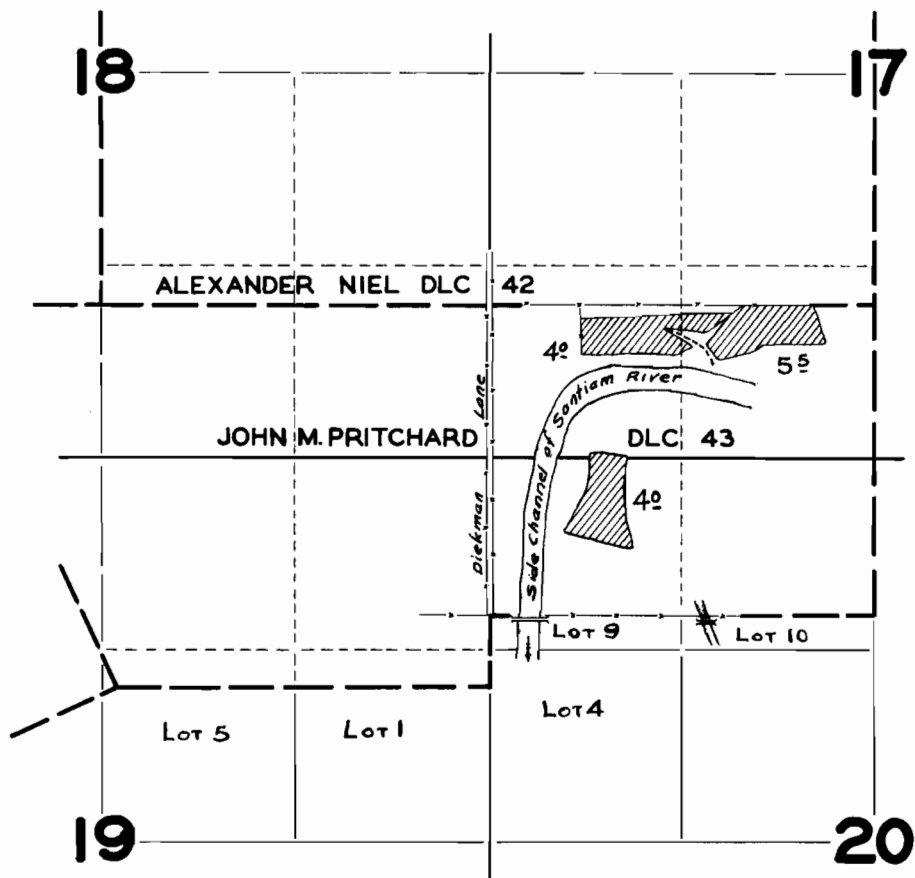

**FINAL PROOF SURVEY**  
UNDER

Application No. 18952 Permit No. 14554

IN NAME OF

J. B. Van Cleve

Surveyed July 29, 1943, by Geo. V. Jaderman