


T. 5S. R. 3W. W.M.

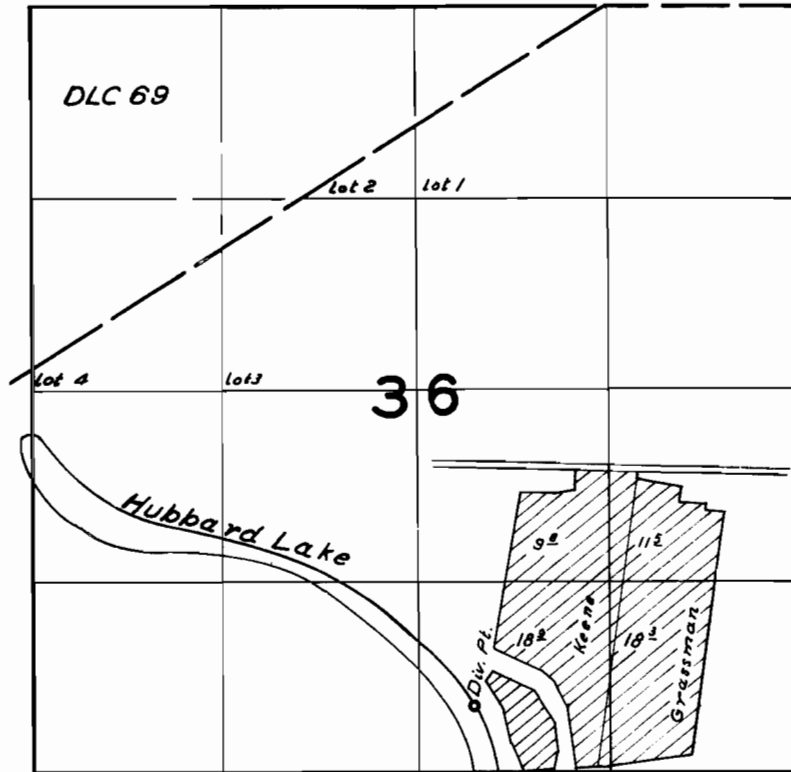

**FINAL PROOF SURVEY**  
UNDER

Application No. 29281... Permit No. 23615...  
IN NAME OF

*E. D. Grassman & Carter Keene*

Surveyed June 10, 1959, by C. O. Bartels...