


T. 9S. R. 3W. W.M.

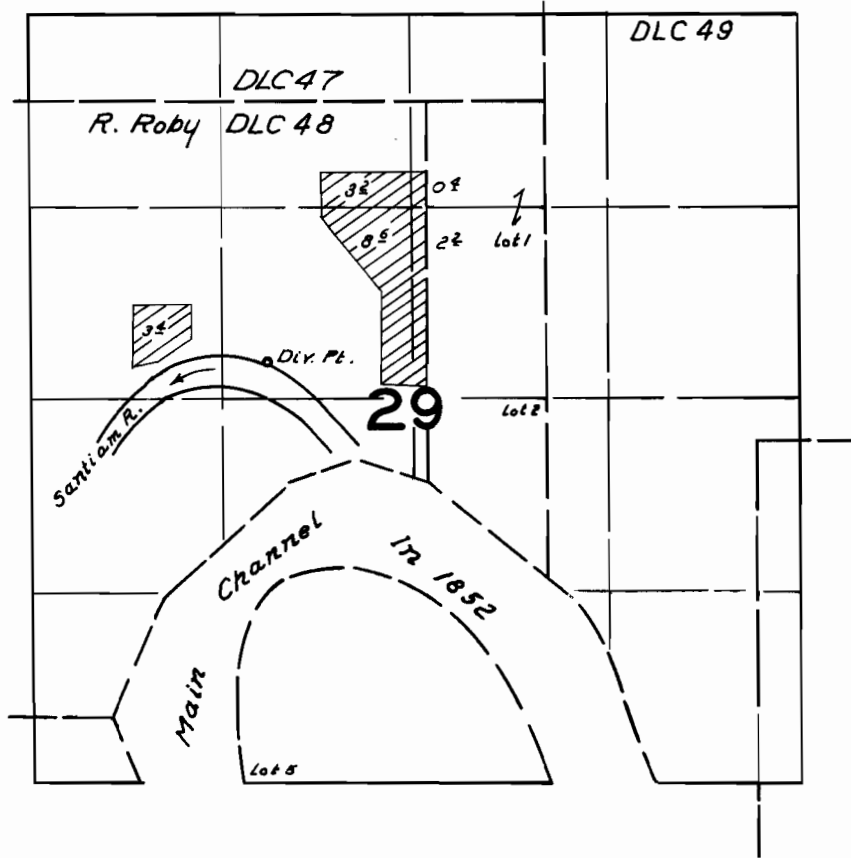

**FINAL PROOF SURVEY**  
UNDER

Application No. 30515... Permit No. 24026...  
IN NAME OF

*Albert E. Cole*

Surveyed April 30 1959, by C.O. Bartels