


T. 5 S. R. 3 W. W.M.

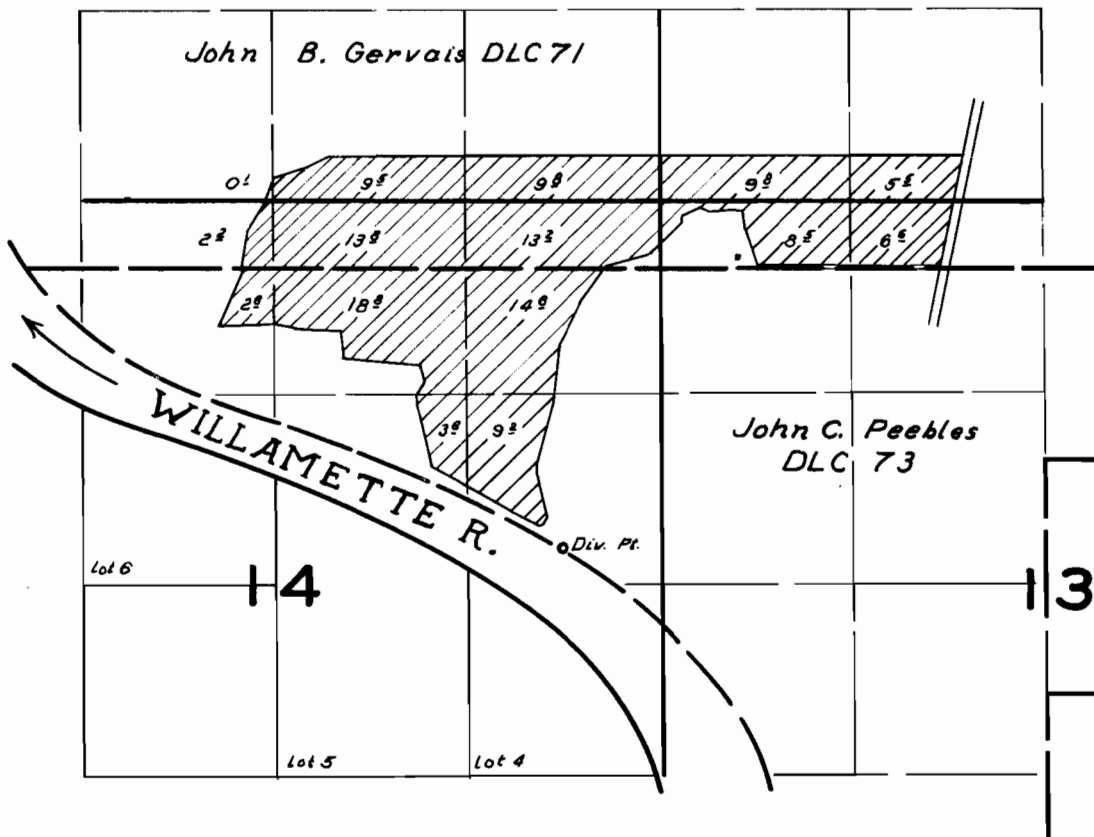

FINAL PROOF SURVEY
UNDER

Application No. 30517 Permit No. 24028
IN NAME OF

Donald F. Coleman

Surveyed June 11 1959, by C. O. Bartels.