


# T.6 S. R.1W.W.M.

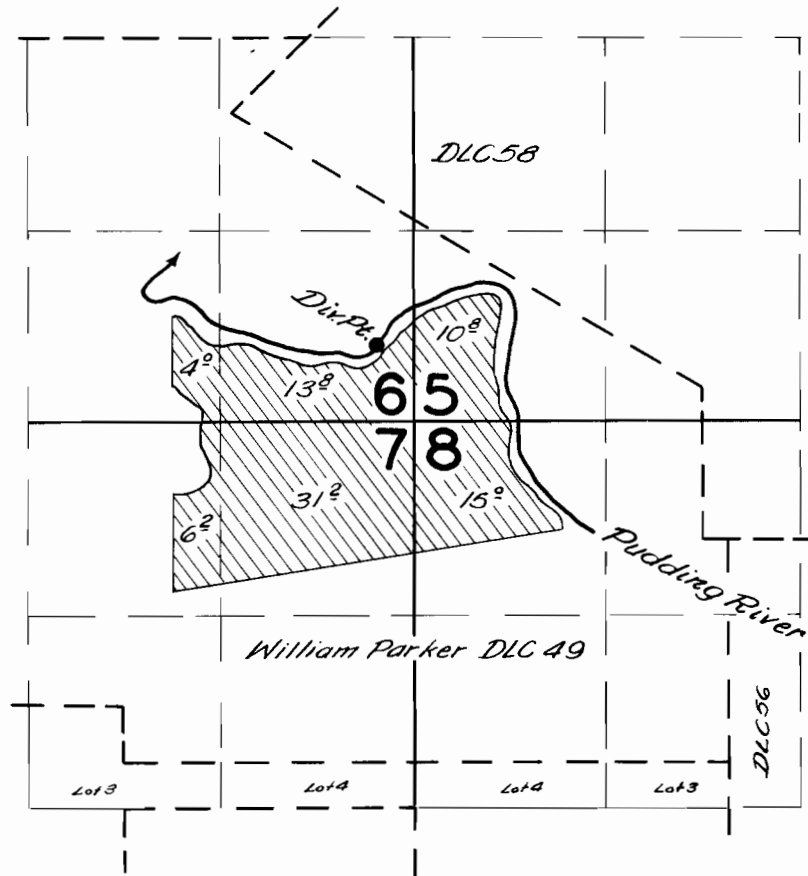

## FINAL PROOF SURVEY UNDER

Application No. 30957 Permit No. 24352  
IN NAME OF

Surveyed *June 27 1958*, by *M. Bish*