


T. 6S. R. 1W. W.M.

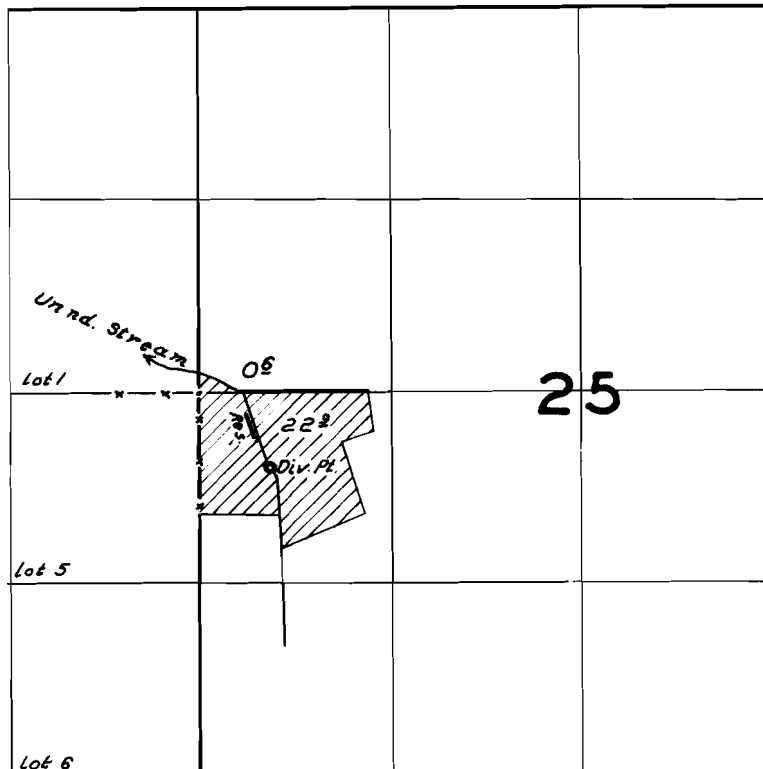

FINAL PROOF SURVEY
UNDER

R-31257 R-1972
Application No. 31258 Permit No. 24627
IN NAME OF

..... Harold J. Alrick

Surveyed May 28 1959, by C.O. Bartels