


T. 6S. R. 1W. W.M.

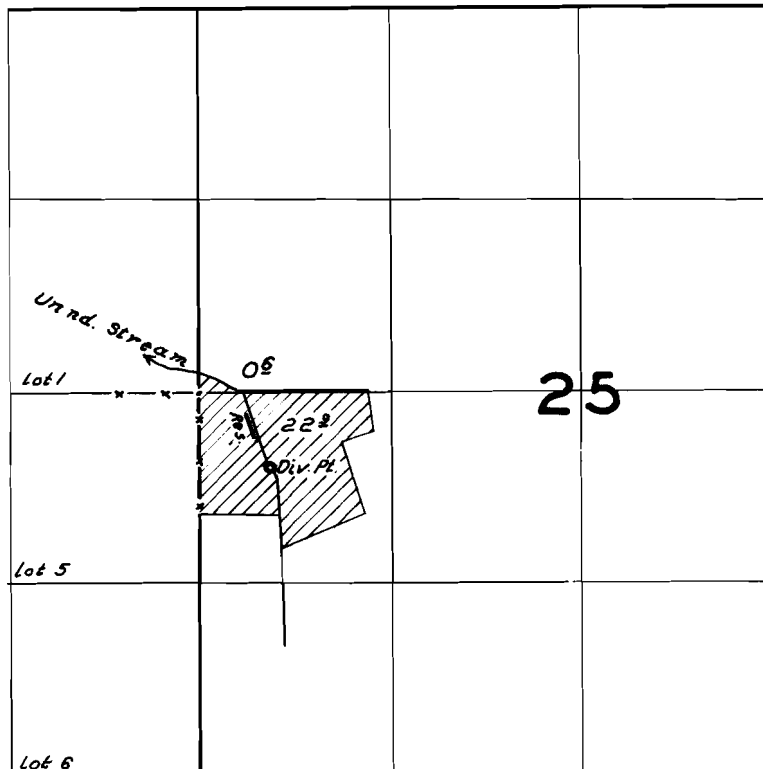

FINAL PROOF SURVEY
UNDER

R-31257 R-1972
Application No. 31258 Permit No. 24627
IN NAME OF

..... *Harold J. Alrick*

Surveyed *May 28 1959*, by *C.O. Bartels* ..