


T. 8S. R. 6W. W.M.

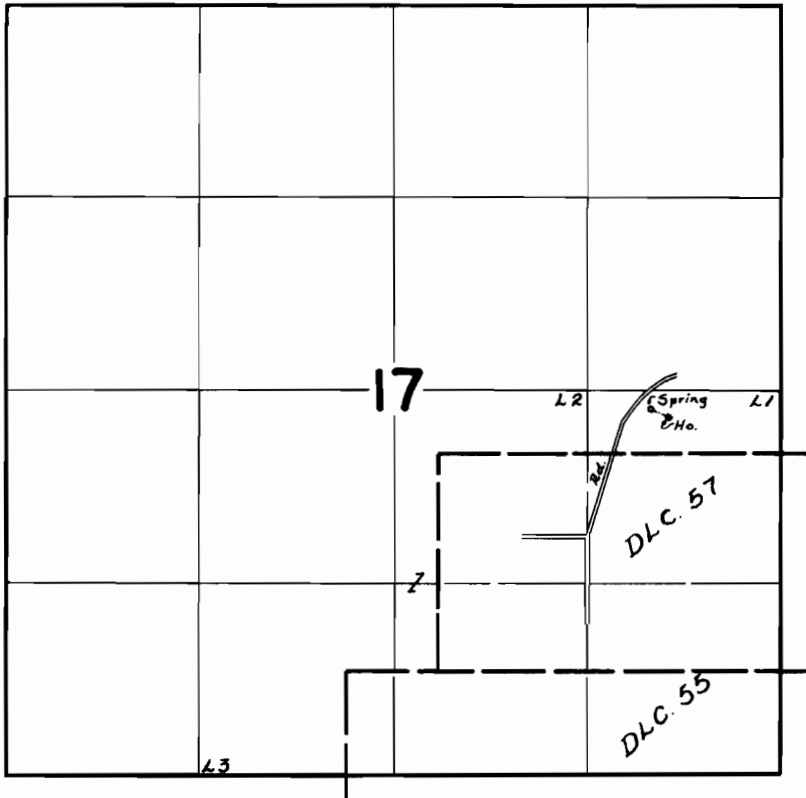

FINAL PROOF SURVEY

UNDER

Application No. 27943 Permit No. 22003
IN NAME OF

George Kenneth Sample

Surveyed Nov. 7 1958, by C.O. Bartels