


T. 5S. R. 11W. W.M.

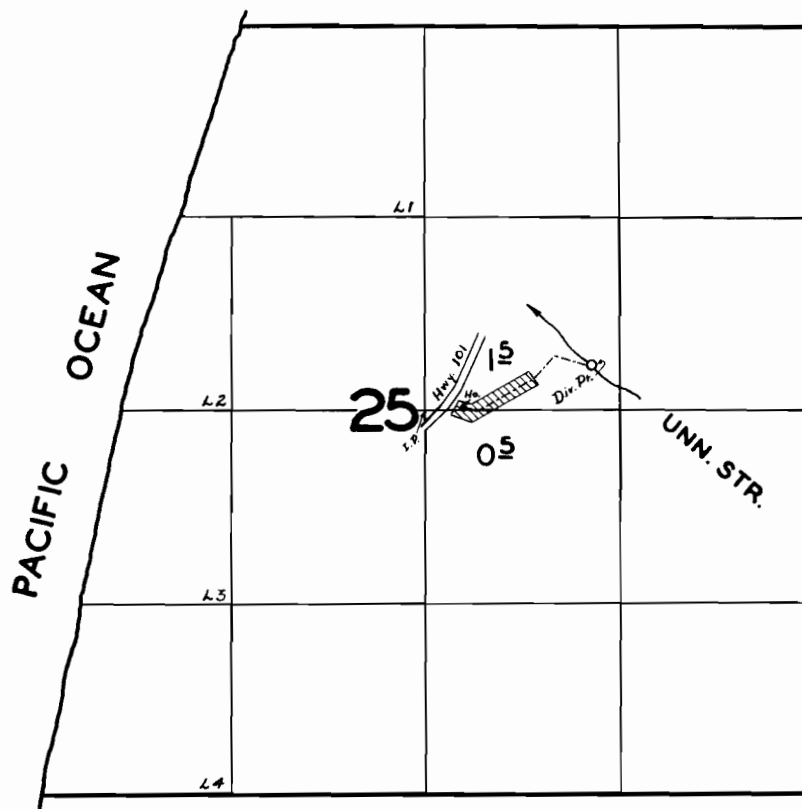

FINAL PROOF SURVEY
UNDER

Application No. 27186 Permit No. 21380
IN NAME OF

WALLY AFFOLTER

Surveyed APR. 17 1959, by M. BISH