


T. 4S. R. 10W. W.M.

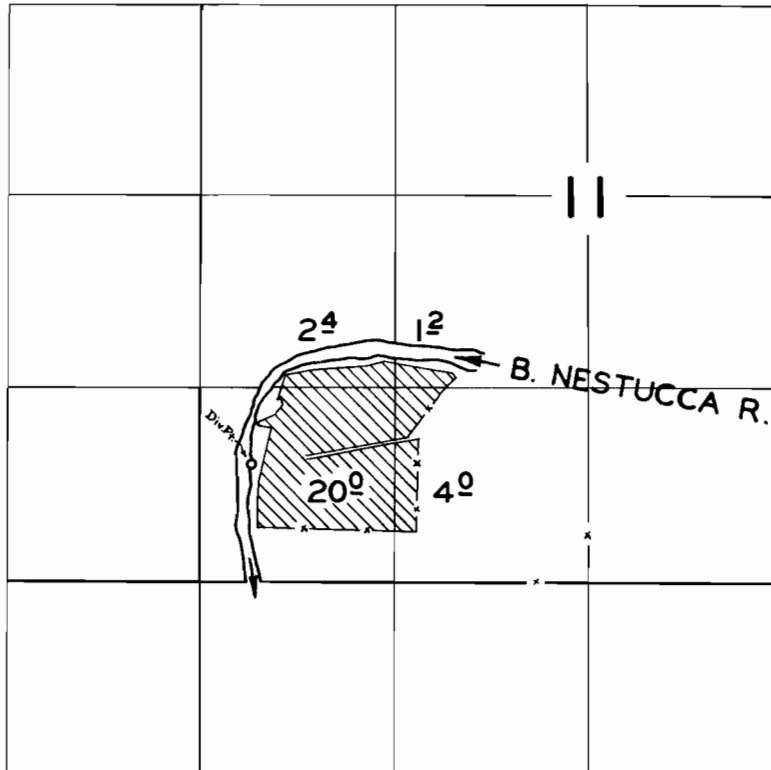

FINAL PROOF SURVEY
UNDER

Application No. 28368 Permit No. 22383
IN NAME OF

ALLIE BROUGHTON

Surveyed APR. 20 1959, by M. BISH