


T. 3S. R. 10W. W. M.

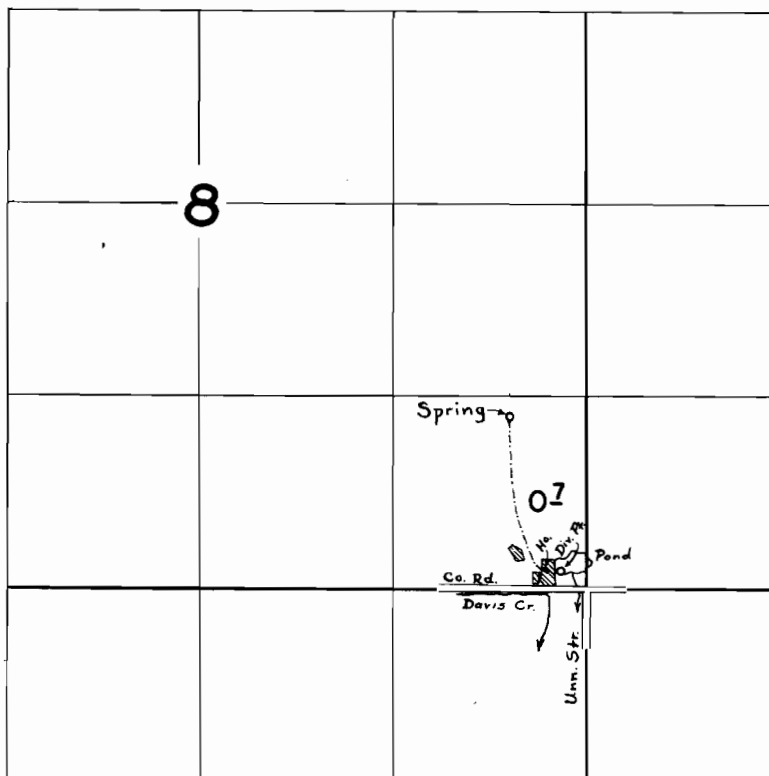

FINAL PROOF SURVEY
UNDER

Application No. 29937 Permit No. 23586
IN NAME OF

ULYSSES & LORENA EDWARDS

Surveyed APR.24. 1959, by M. BISH