


T. 5S. R. 10W. W.M.

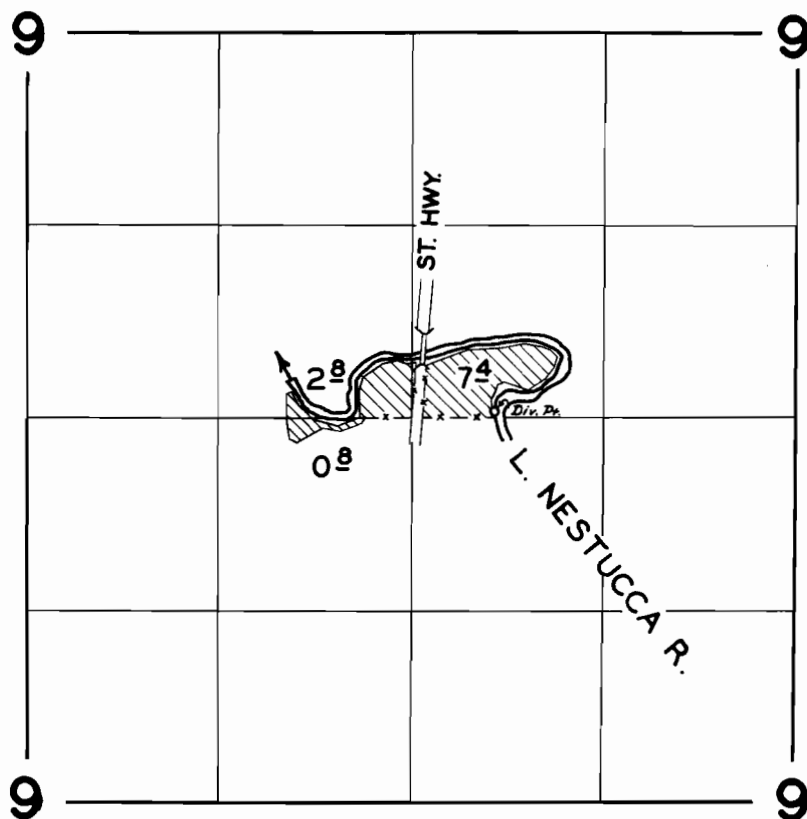

FINAL PROOF SURVEY
UNDER

Application No. 30098 Permit No. 23764
IN NAME OF

ROY C. & LORETTA I. DUNN

Surveyed APR. 22 1959, by M. BISH