


T. 4S. R. 10W. W.M.

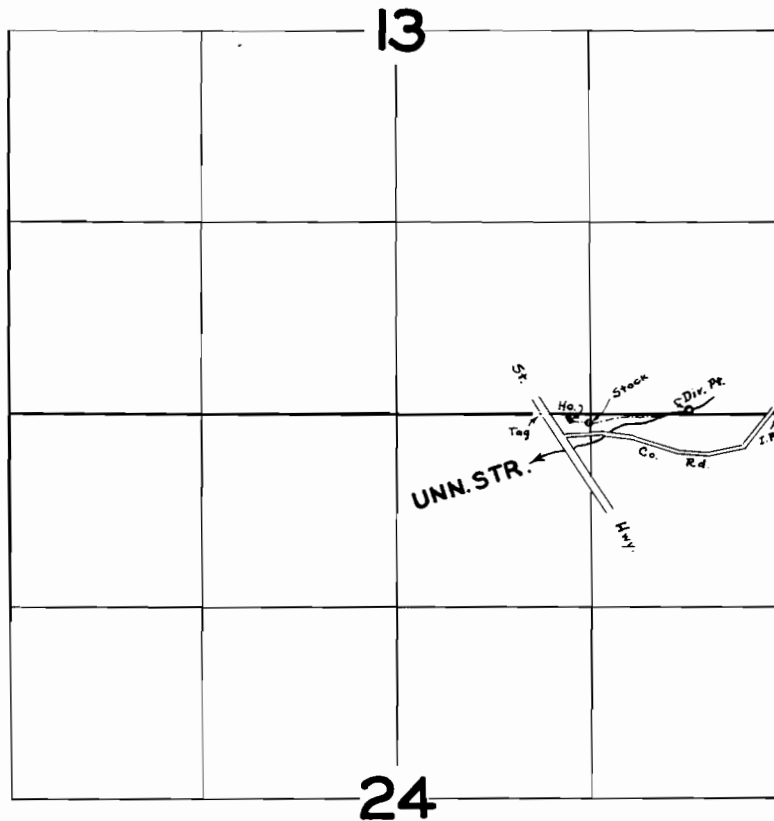

FINAL PROOF SURVEY
UNDER

Application No. 30354 Permit No. 23874
IN NAME OF

CHARLES W. HAGLUND

Surveyed APR. 14 1959, by M. BISH