


T. 3S. R. 9W. W.M.

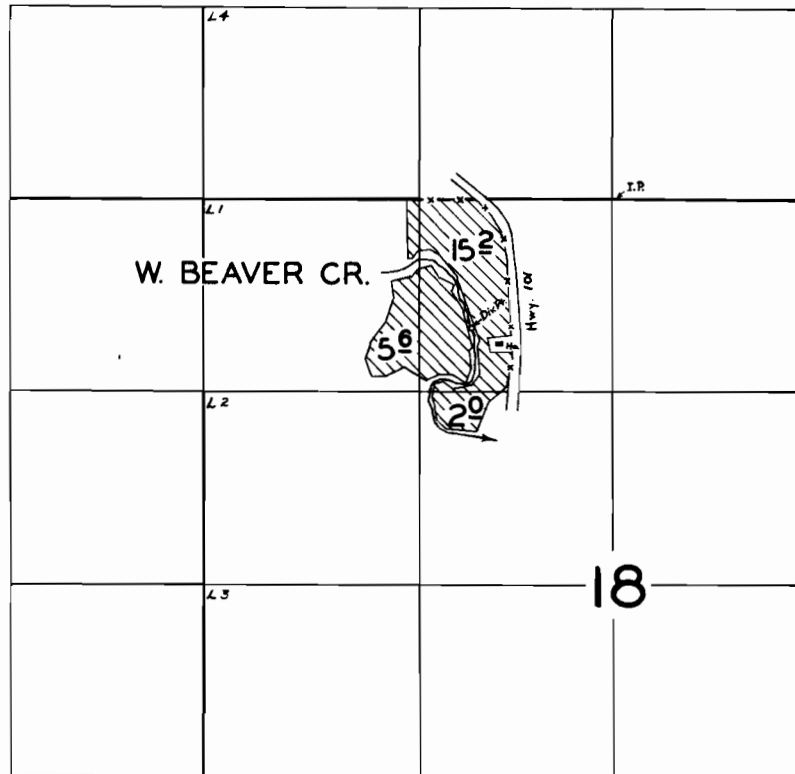

FINAL PROOF SURVEY
UNDER

Application No. 30680 Permit No. 24177
IN NAME OF

ALVIN GLAWE

Surveyed APR. 16 1959, by M. BISH