


SURVEYORS CERTIFICATE

I, W. E. Anderson of Tillamook Ore do hereby certify that this map was made from notes taken during an actual survey made by me, and the point of diversion has 1 1/2" I.P. placed at the dam site with co-ordinates with reference to the S.W. Cor of SE 1/4 of NE 1/4 SEC. 10. T. 15. R. 8 W. N. 11.

W. E. Anderson

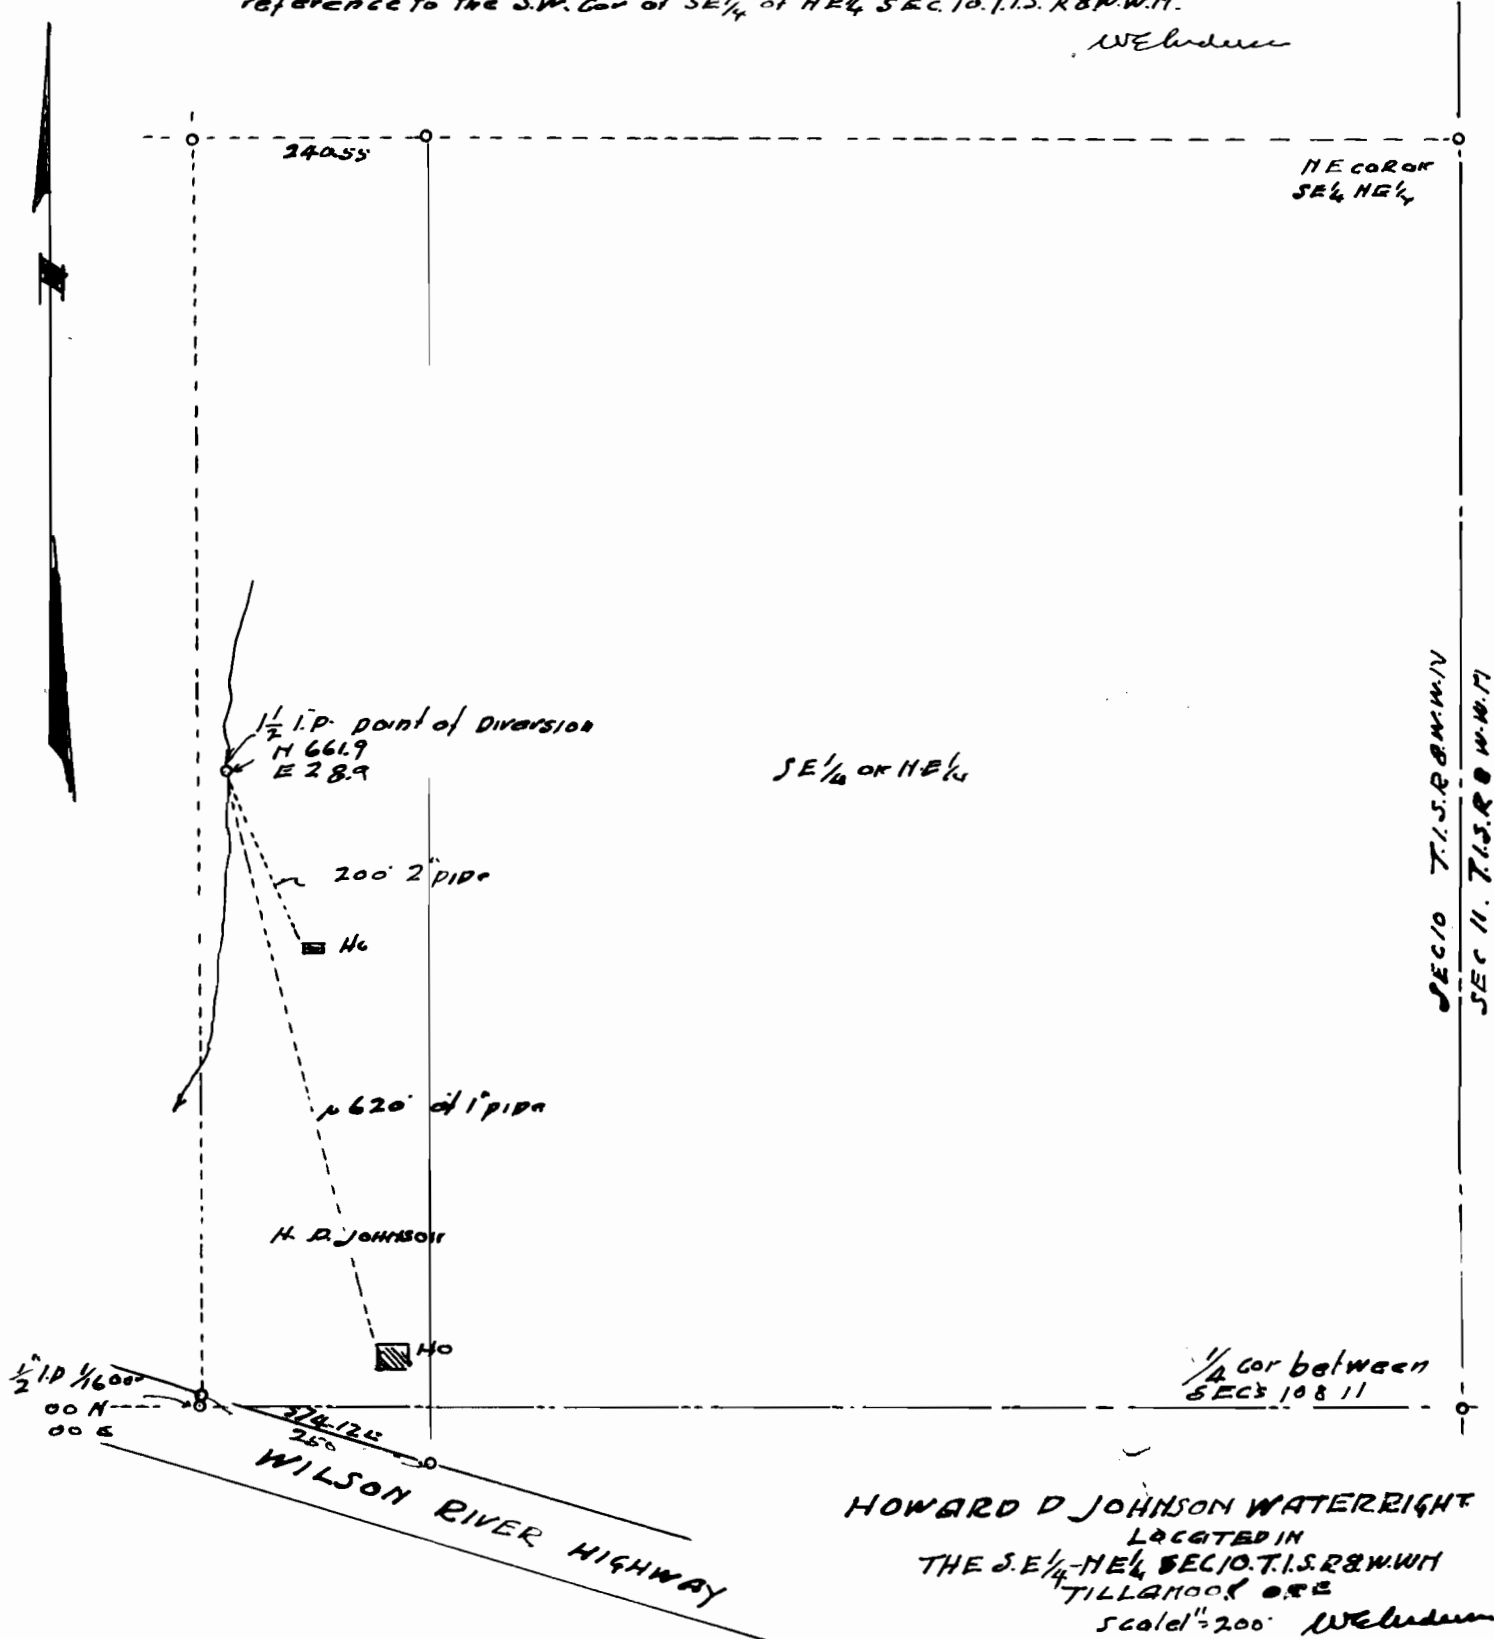

HOWARD D JOHNSON WATERRIGHT
LOCATED IN
THE S.E. 1/4 - NE 1/4 SEC. 10. T. 15. R. 8 W. N. 11
TILLAMOOK ORE

Scale 1" = 200' W. E. Anderson

30708

24591