


T. 3S. R. 10W. W.M.

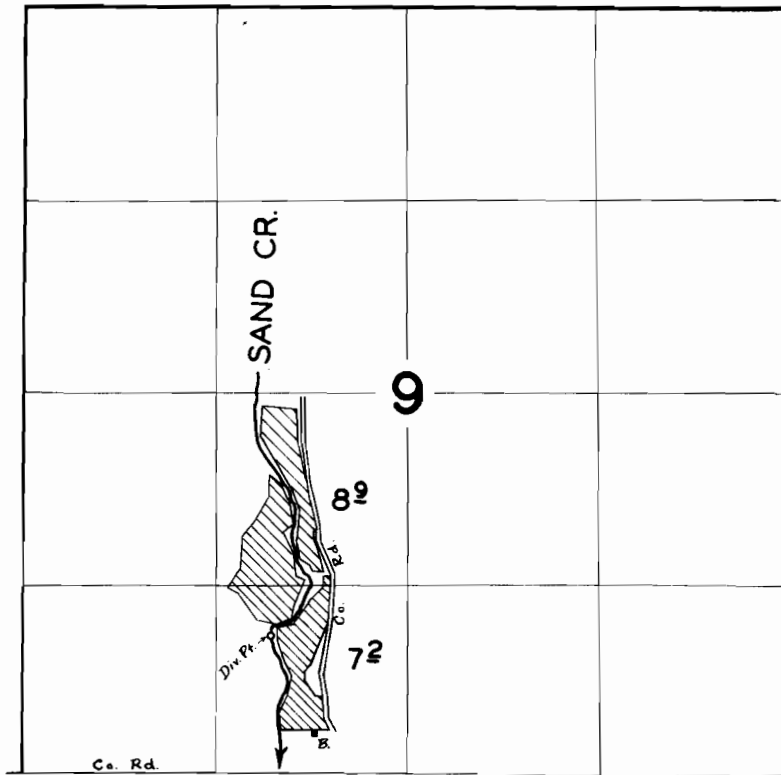

**FINAL PROOF SURVEY**  
UNDER

Application No. 31673 Permit No. 24983  
IN NAME OF

**JOHN GREEN**

Surveyed APR. 23 1959, by M. BISH