


U-340

C-27726

T.6 N. R.34E.W.M.

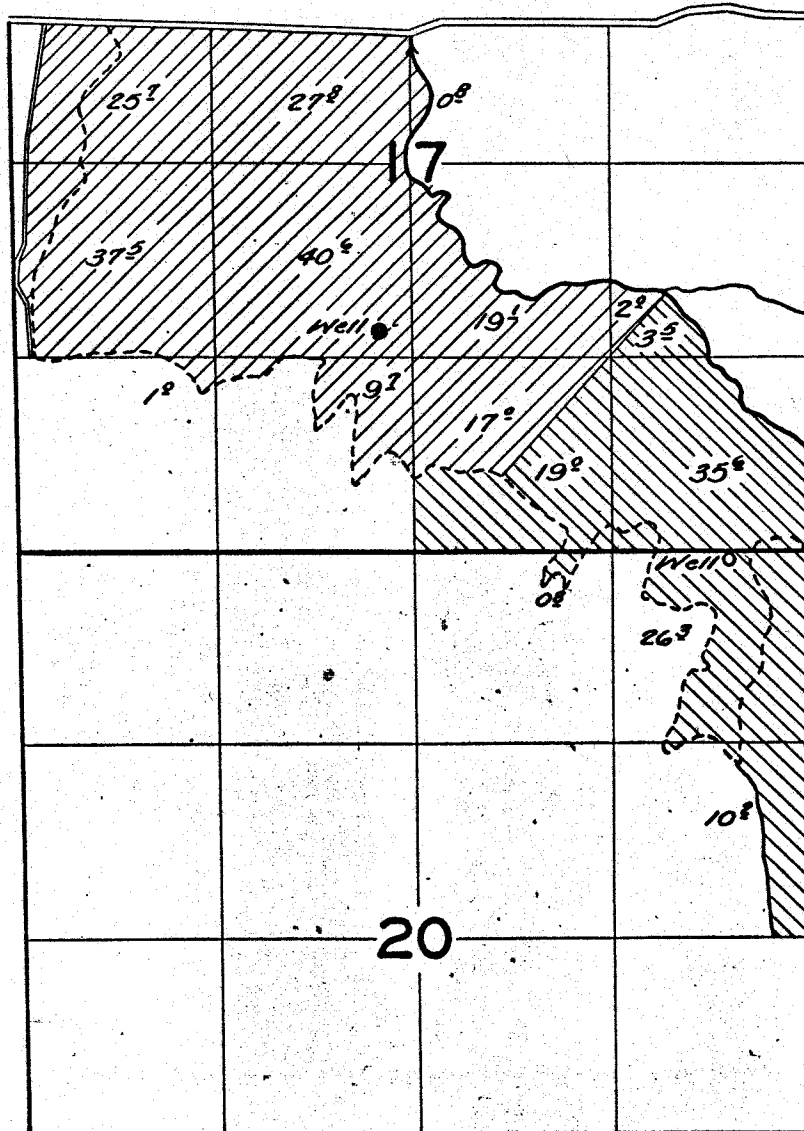

FINAL PROOF SURVEY UNDER

Application No. U-375... Permit No. U-340...
IN NAME OF

Raymond Bevans

Surveyed Oct. 27... 1959, by A.O. Bartels...