


T.6N.R.34E.W.M.

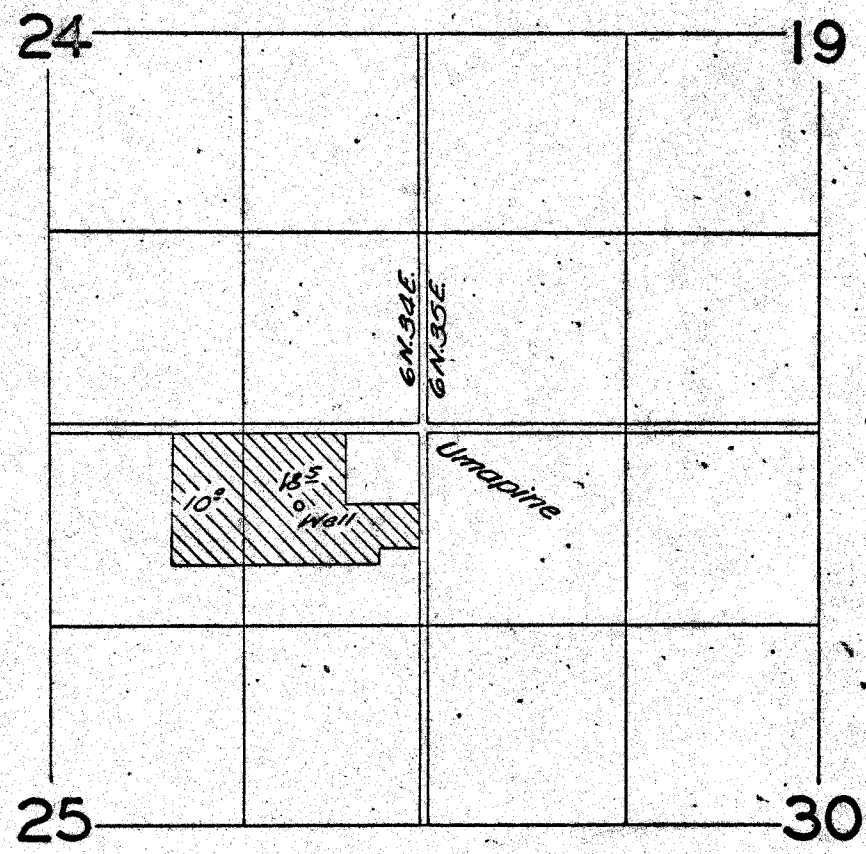

FINAL PROOF SURVEY

UNDER

Application No. G-1074 Permit No. G-1029

IN NAME OF

A.H. Schubert

Surveyed Oct. 22 1959, by C.O. Burtch