


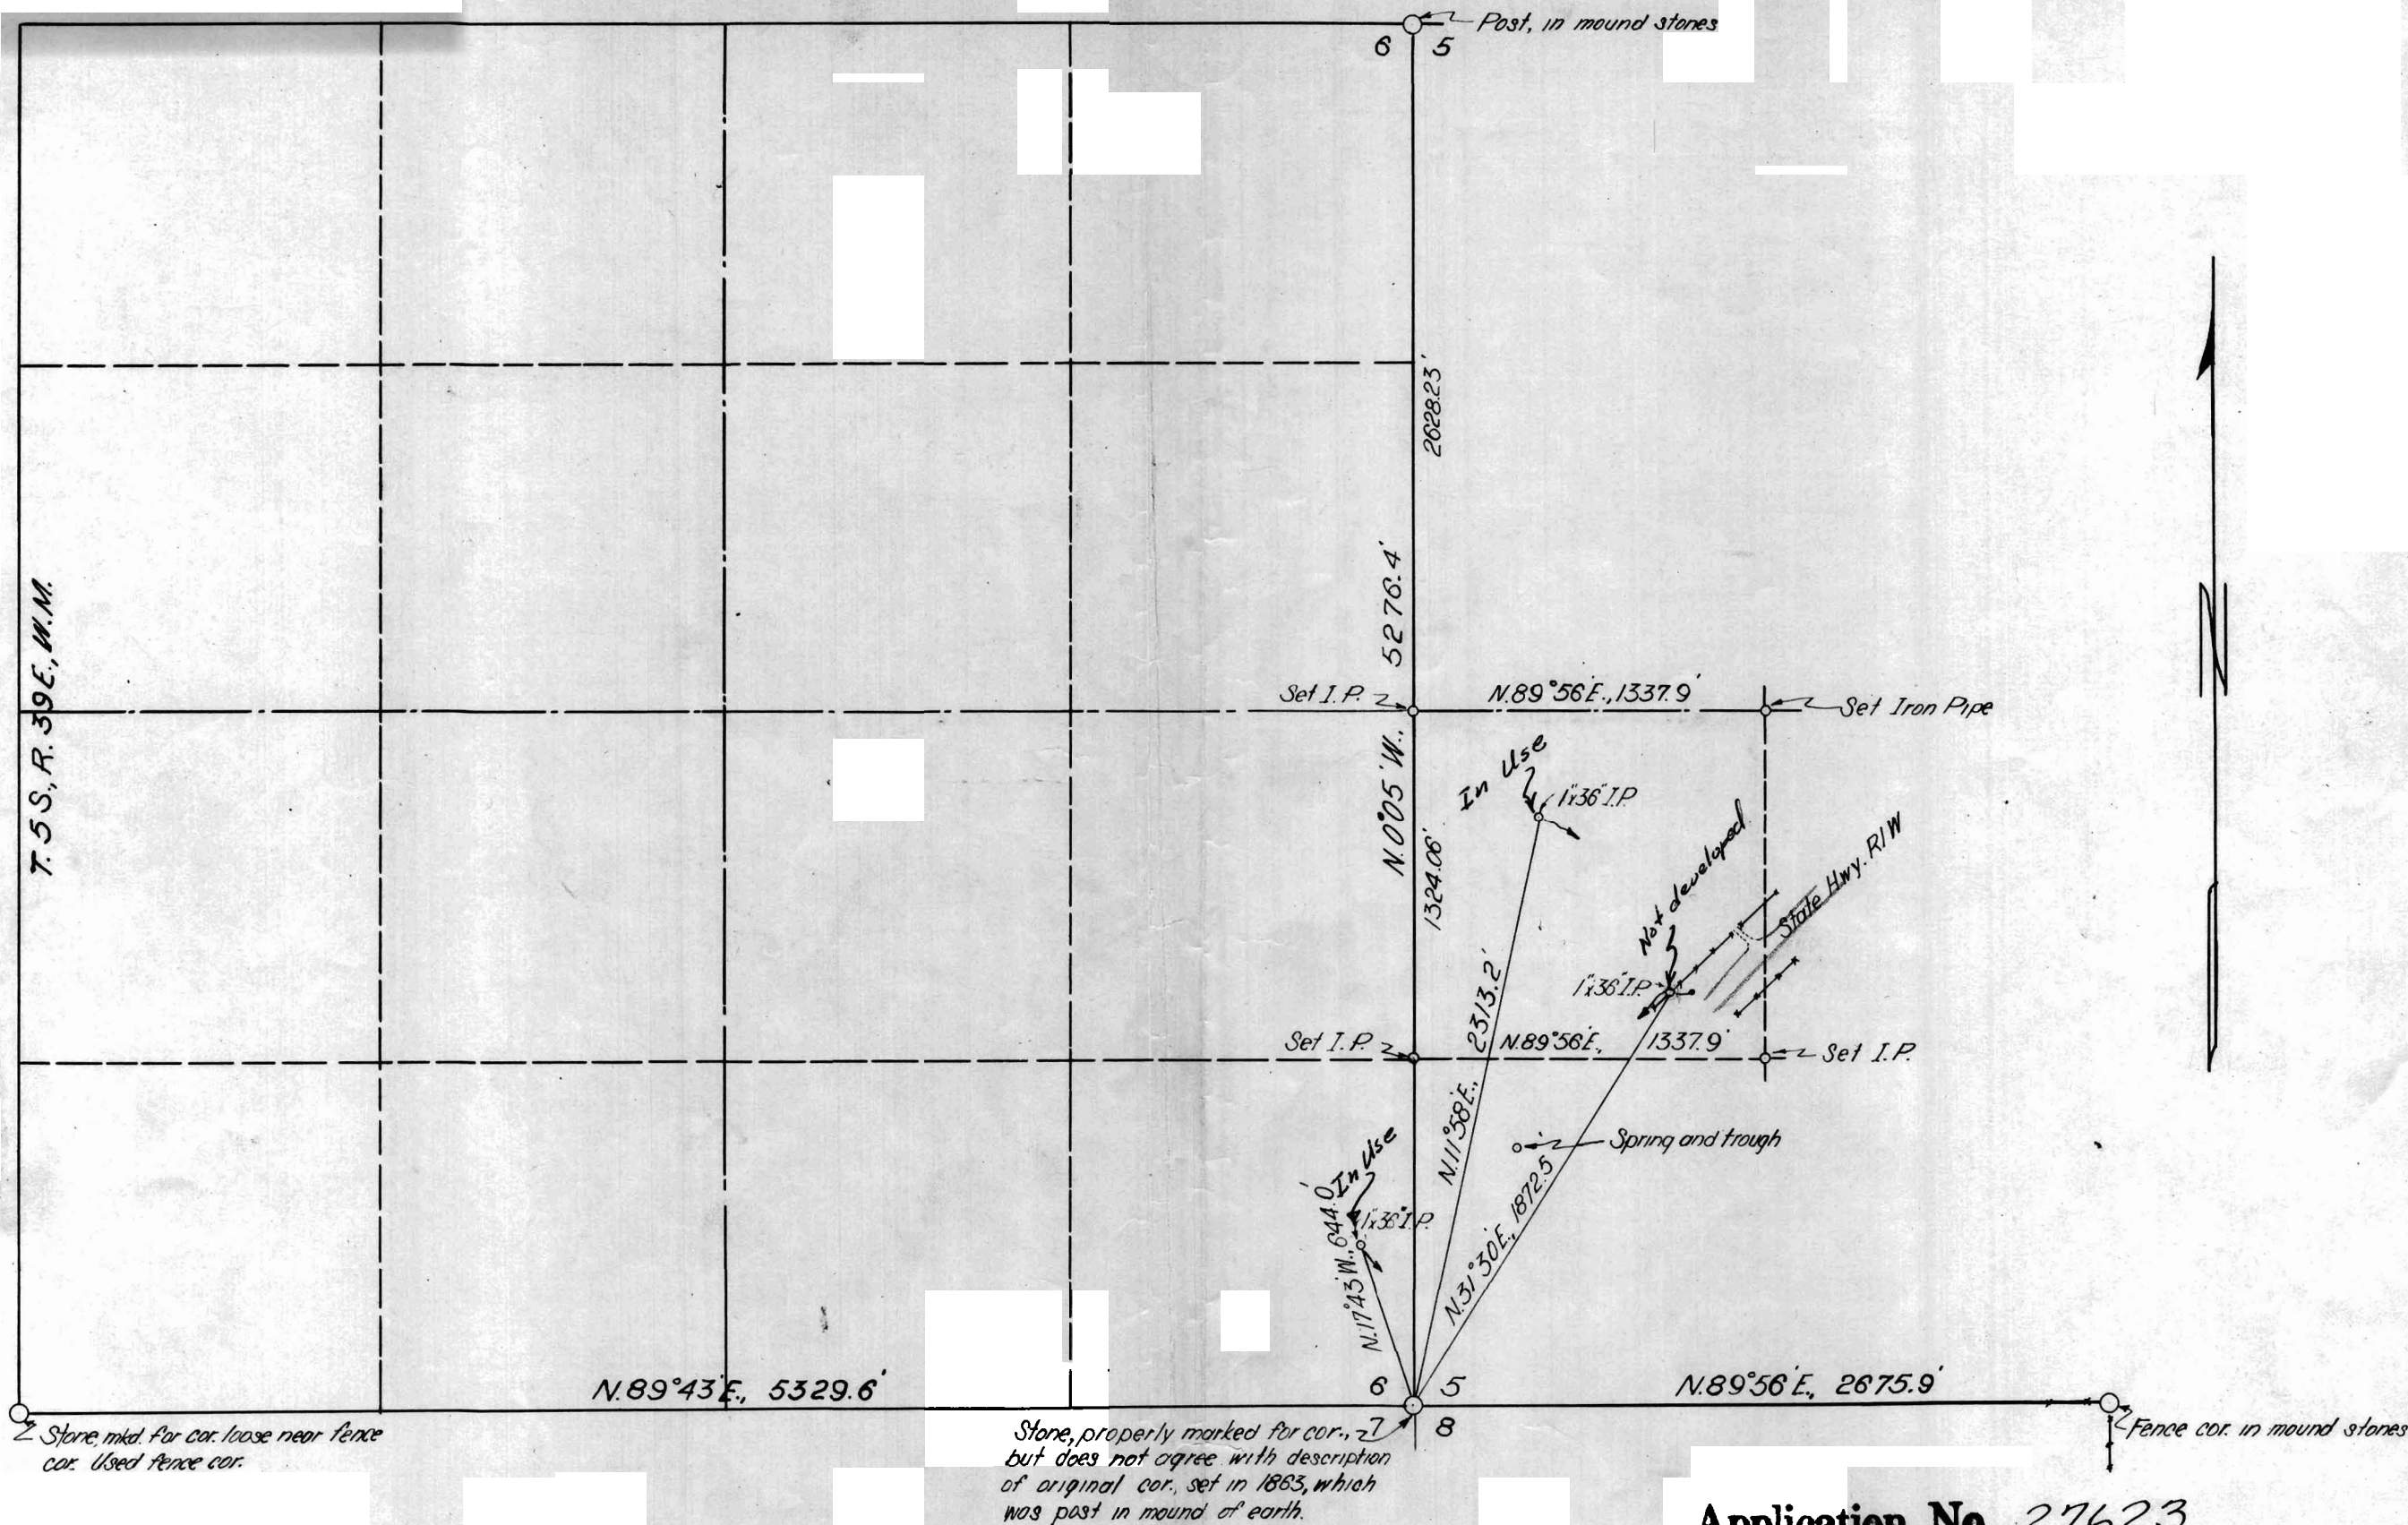

Application No. 27623
Permit No. 21759

I, James D. Hanley, of Baker, Oregon, do hereby certify that this map was made from notes taken during an actual survey made by me on Aug 30 and Sept. 1, 1952; that the monuments shown on this map, consisting of three 1"x36" iron pipes bear N.17°43'W., 644.0'; N.11°58'E., 2313.2'; and N.31°30'E., 1872.5 respectively from the SE corner of Section 6, T.5S., R.39E., W.M.

James D. Hanley

MAP OF SURVEY IN SECS. 5 and 6,

T.5S., R.39E., W.M.

Aug. 30 and Sept. 1, 1952

SCALE 1"=660'

RECEIVED
SEP 8 1952
STATE ENGINEER
SALEM, OREGON

