


T.3S. R.40E.W.M.

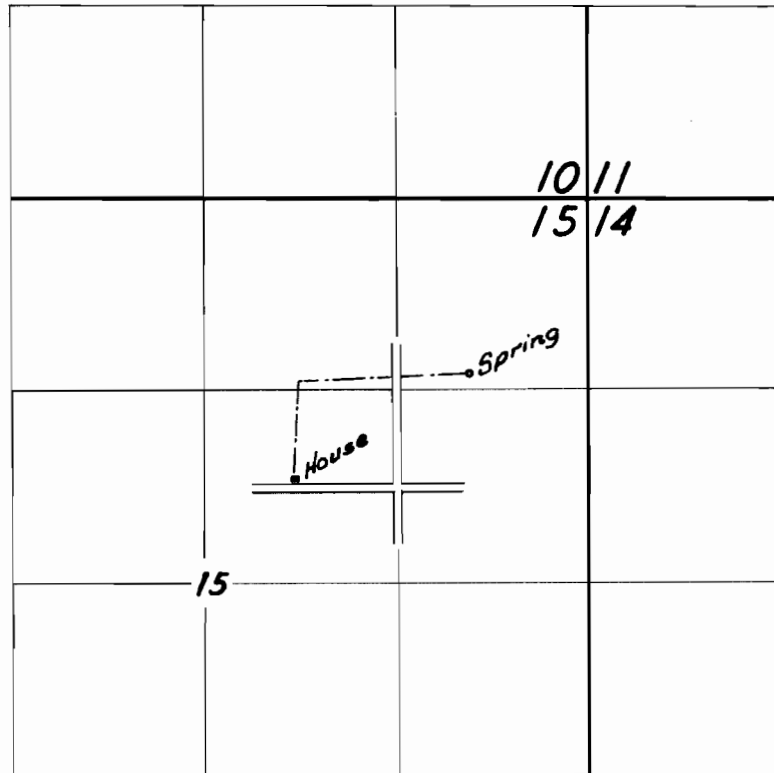

FINAL PROOF SURVEY

UNDER

Application No. ~~27899~~ Permit No. ~~21976~~

IN NAME OF

-----  
Surveyed *Aug. 6, 1959*, by *C.O. Baiter*