


T.2N. R.13E. W.M.

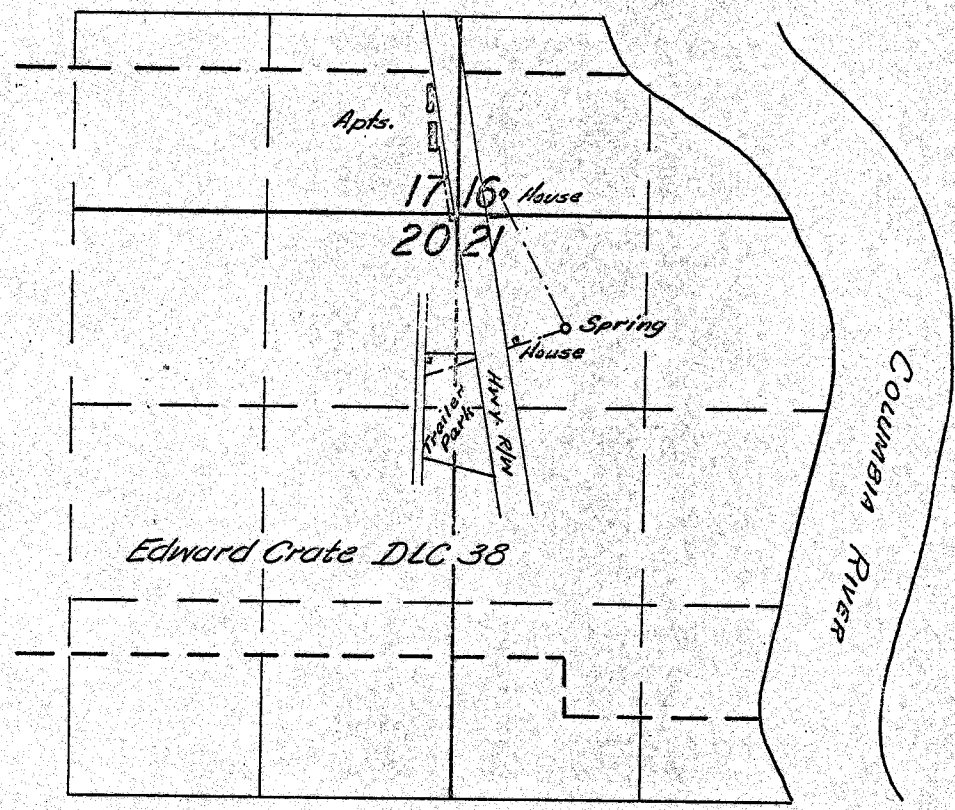

FINAL PROOF SURVEY

UNDER

Application No. 28346 Permit No. 22370

IN NAME OF

W.R. & Eunice Taylor

Surveyed Nov. 16, 1959 by C.O. Curtis