


T. 4S. R. 4W. W.M.

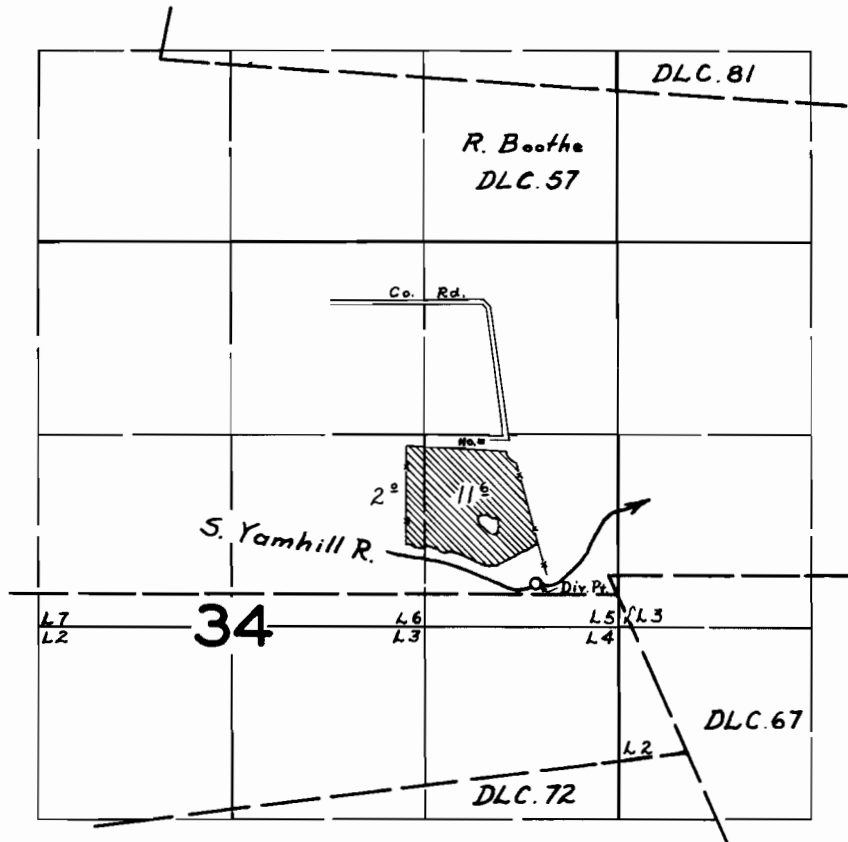

FINAL PROOF SURVEY

UNDER

Application No. 31643 Part of No. 24939

IN NAME OF

Sol J. Yutzzy

Surveyed Sept. 8, 1959, by M. Bish