
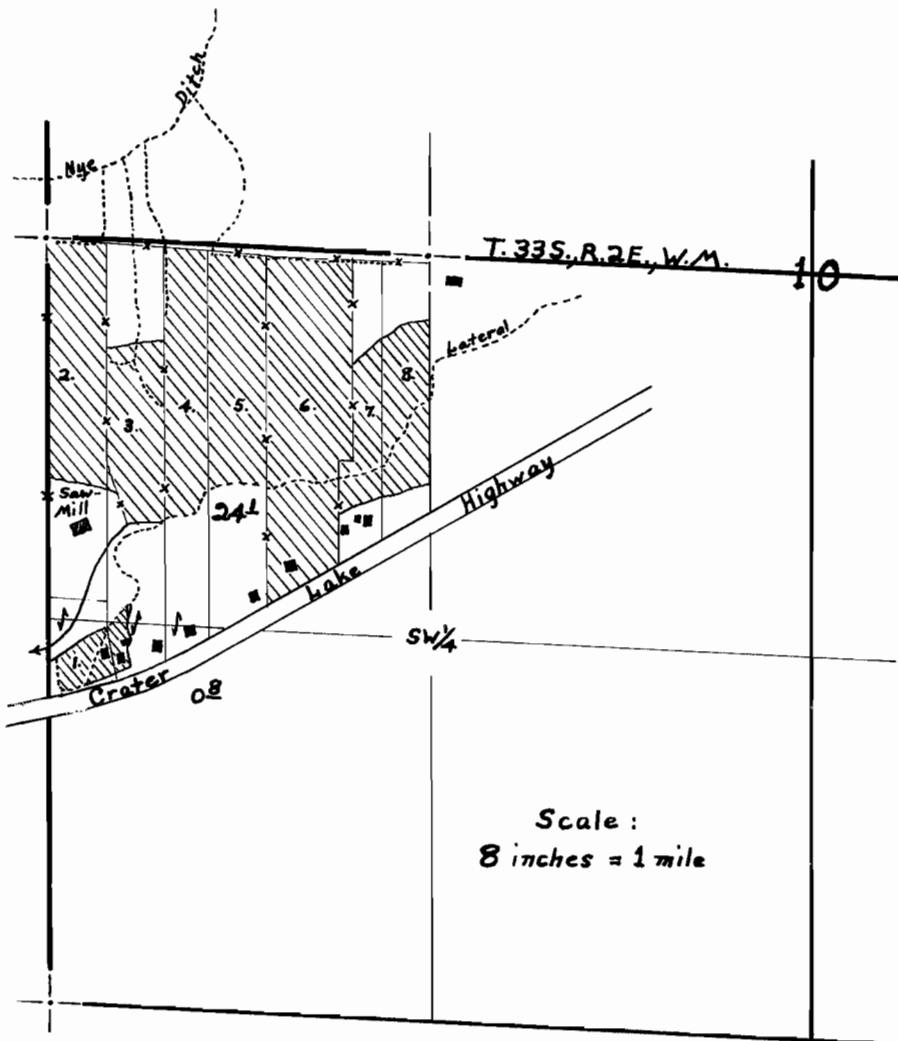


N 1/4 Cor. Sec. 16

T. 32 S., R. 3 E., W. M.

Map showing correct point of diversion of Nye Ditch from Mill Creek.

Scale:
8 inches = 1 mile

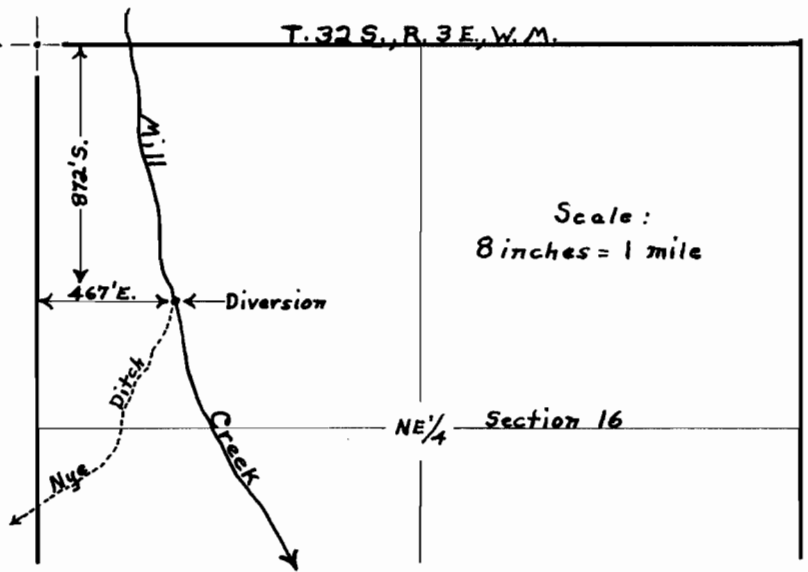

1. Jack DeRosier	0.6 ac.
2. Richard Bean	4.0 ac.
3. Eldon Bean	2.7 ac.
4. A. S. Hammon	3.1 ac.
5. Frank Helms	3.7 ac.
6. D. M. Chandler	7.2 ac.
7. Art Dorson	1.5 ac.
8. G. L. Jantzer	2.1 ac.
Total	24.9 ac.

Scale:
8 inches = 1 mile

Map to accompany final papers of
Richard Bean and Associates.

Application No. 18675

Plane table survey made Nov. 10,
1955 and Jan. 17, 1956.

Permit No. 14306

David C. Hendrix, Watermaster.