


T.11S.R.5W.W.M.

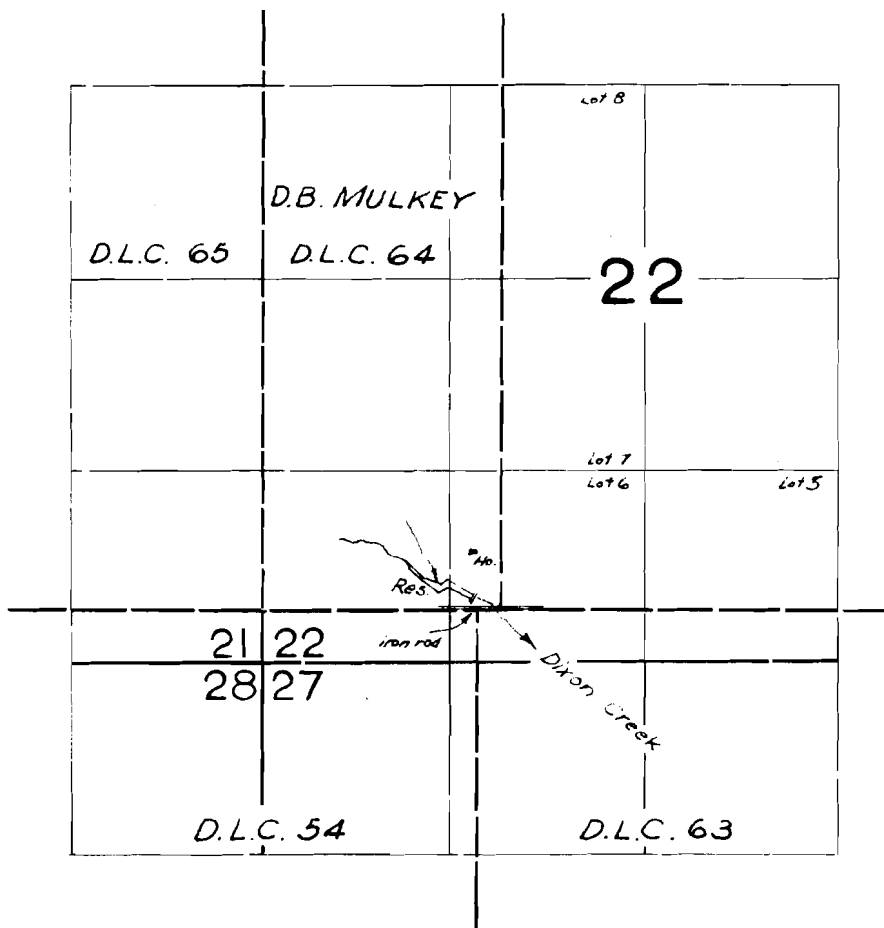

FINAL PROOF SURVEY
UNDER

R-31151 R-1951
Application No. 31152 Permit No. 24550
IN NAME OF

Surveyed 9 March 1959, by *R.H. Jackson*